


# KANSAS

Barton

Section 31 Township 17 Range 13W

Well No. 1 Sette "A"

Company Republic Natural Gas

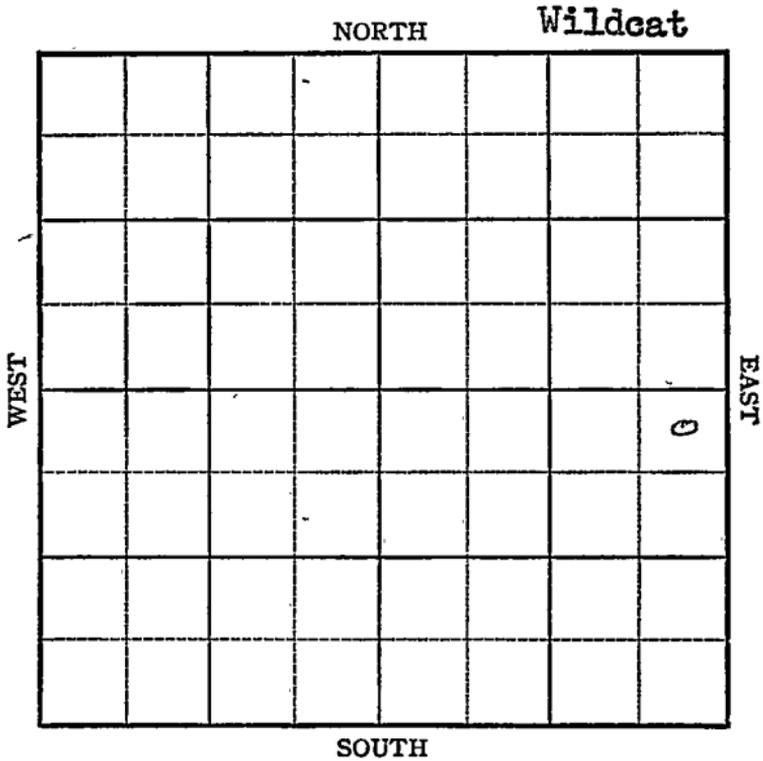

**KANSAS**

Barton

✓ 13W

Sec. 31 Twp. 17 R. \_\_\_\_\_

Well No. #1 Sette "A" Farm \_\_\_\_\_

Republic Natural Gas Company


Wildcat

\_\_\_\_\_ Ft. from N. Line

330' Ft. from S. Line

330' Ft. from E. Line

\_\_\_\_\_ Ft. from W. Line

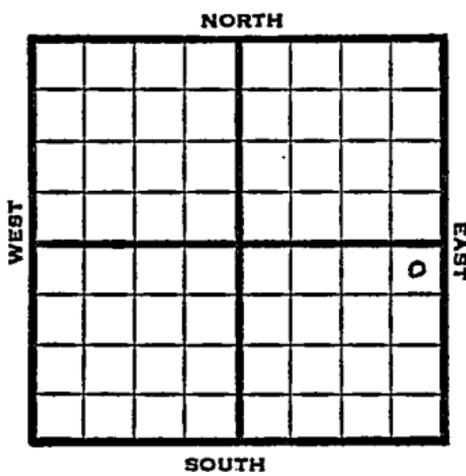

NE SE

1949	Elev 1837'	REPORT
2/23	Drlg. 310'	
3/2	8"@ 815'	
	Drlg 2787'	
3/8	Lansing 3130'	
	Arb. 3354'	
	5"@ 3356'	
	TD 3364'	
3/16	18 shots 3356-63'	
	4000 acid	
	Swb 5 bbls oil PH 8 hrs.	
3/23	"	
3/30	1000 acid wtr.	
4/6	"	
4/12	Pump 96 bbls wtr / 6 bbls oil 24 hrs.	
4/20	"	"
4/27	"	"
5/4	"	"
5/10	"	"
5/18	TD 3364'	
	Arb. 3354'	
	Aband.	

**ABANDONED**

Kansas

Wildeat

Map No. \_\_\_\_\_ Sec. 31 Twp. 17 R. 13W

Well No. 1 Sette "A"

Republic Natural Gas Company

FIRST REPORT Contractor

NE SE

SECTION PLAT

\_\_\_\_\_ Ft. from N. Line  
330 Ft. from S. Line  
330 Ft. from E. Line  
 \_\_\_\_\_ Ft. from W. Line

			o

Barton County

Location \_\_\_\_\_

Rig up \_\_\_\_\_

Drilling and Remarks:

drlg. 310

RECORD

Cased \_\_\_\_\_ in., \_\_\_\_\_ ft.  
 Sand \_\_\_\_\_  
 Gas \_\_\_\_\_  
 Oil \_\_\_\_\_  
 Total Depth \_\_\_\_\_

PRODUCTION

1st 24 hrs. Nat. \_\_\_\_\_  
 1st 24 hrs. after shot \_\_\_\_\_  
 Gas \_\_\_\_\_ Cu. Ft.  
 Dry Hole \_\_\_\_\_  
 Abandoned \_\_\_\_\_

Date

FEB 23 1949 19

S. J. LEWIS

Scout

Map No. K79 Sec. 31 Twp. 17 R. 13W

Well No. 1 Sette "A"

Republic Natural Gas Company

**ABANDONED**

Contractor

NE SE

*E111837*  
**SECTION PLAT**

\_\_\_\_\_ Ft. from N. Line

330 Ft. from S. Line

330 Ft. from E. Line

\_\_\_\_\_ Ft. from W. Line

Barton County

			o

Location \_\_\_\_\_

Rig up \_\_\_\_\_

Drilling and Remarks:

*Per X3354*

**RECORD**

Cased \_\_\_\_\_ in., \_\_\_\_\_ ft.

Sand \_\_\_\_\_

Gas \_\_\_\_\_

Oil \_\_\_\_\_

Total Depth 2364

**PRODUCTION**

1st 24 hrs. Nat. \_\_\_\_\_

1st 24 hrs. after shot \_\_\_\_\_

Gas \_\_\_\_\_ Cu. Ft.

Dry Hole \_\_\_\_\_

Abandoned \_\_\_\_\_

Date

MAY 18 1949 19

S. J. LEWIS Scout