

Barton

KANSAS

SECTION 31 TOWNSHIP 17 RANGE 13 W

WELL NO. #1 Sette

COMPANY Advance Drig.

NORTH

						0	

WEST

EAST

SOUTH

Barton

KANSAS

SEC.	TWP.	R.
31	17	13W

WELL NO.

#1 Sette

FARM

COMPANY

Advance Drlg.

CONTRACTOR

Shields

WILDCAT


Ft. from N. Line

Ft. from S. Line

Ft. from E. Line

Ft. from W. Line

SW SE NE.

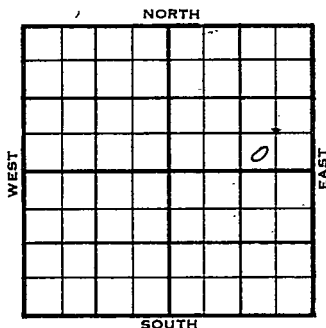

1955

ELEVATION
1861'

REPORT

11-23

Comm. 11-14-55
 8" @ 727/400
 Drlg. 2423
 Anh. 800'

11-30

DST 3342-45 op $\frac{1}{2}$ hr. rec. 10' mud, 0/20'
 DST 3345-60 op 30 min. rec. 10' drlg.
 mud, 0/20"
 D & A
 Anh. 800'
 L. 3134
 C. 3329
 A 3349
 TD 3370'

ABANDONED

County Barton Elev. _____
 Sec. 31 Twp. 17 Rge. 13W
 Company Advance Drlg.
 FarmName Sette No. 1

TOPS	DEPTH	LOG	DATUM	Loc. in Sec.
Anh.	800			SW SE NE
Tr.				
H.				
Tr.				
Dg.				
BL.				
L.				
K.C.				Geol.
B.K.C.				Contr.
Ce.				Shields
C.				
M.				Pool
M.				Wildcat
K.				
Mz.				
Mo.				
V.				
S.				
S.				
A.				
R.				
Pe.				
G.				
T.D.				

FIRST REPORT
 NOV 23 1955

Date Comm. 11-14-55
 8" @ 727/400 drlg. 2423

Co.

Lse.

No.

Sec.

T.

R.

County Barton Elev. 1861
 Sec. 31 Twp. 17 Rge. 13W
 Company Advance Drlg.
 Farm Name Sette No. 1

Co.

Lse.

No.

Sec.

T.

R.

TOPS

DEPTH

LOG

DATUM

Loc. in Sec.

Anh. 800
 Tp. SW SE NE
 H.
 Tr.
 Dg.
 Bl.
 L. 3134
 K.C. 1273
 B.K.C.
 Ce.
 C. 3329
 M. 1468
 M.
 K.
 Mz.
 Mq.
 V.
 S.
 S.
 A. 3340
 R. 1479
 P.
 G.
 T.D. 3370

Geol.

Contr.

Shields

Pool

Wildcat

ABANDONED

NOV 30 1955

Date Comm. 11-11-558" @ 727/400 DST 3342-45 open $\frac{1}{2}$ hr.

rec. 10' mud 0/20" DST 3345-60

open 30 min. rec. 10' drlg. mud 0/20"

D & A