


Section 20 Township 13 Range 17W

Well No. #1 Weber.

Company Glen. R. Nye

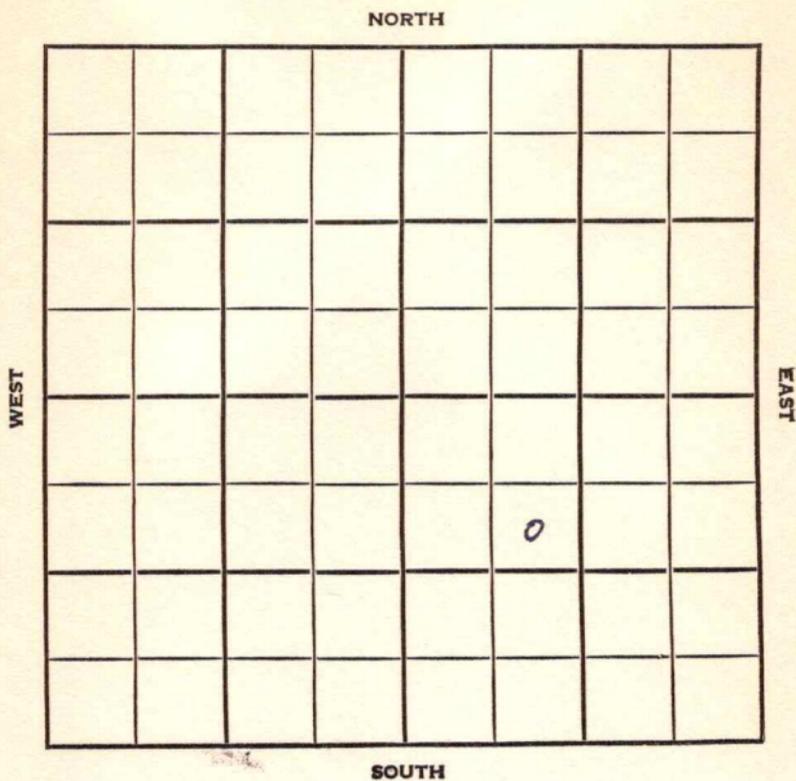


SEC.	TWP.	R.
20	13	17W

WELL NO. #1 Weber FARM

COMPANY Glen R. Nye

CONTRACTOR Co. Tools.

990 Ft. from N. Line  
 Ft. from S. Line  
 Ft. from E. Line  
 990 Ft. from W. Line

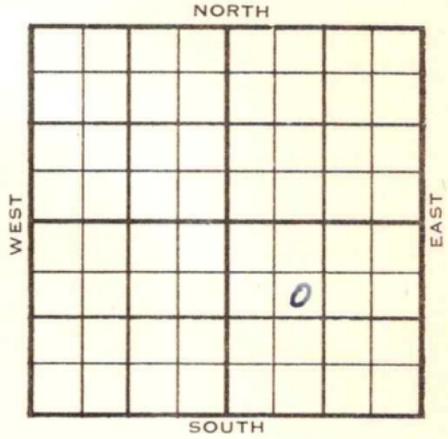

SE NW SE

1955	ELEVATION	REPORT
	2032'	

2/9 Spud 2-5-55  
 8" @ 100'  
 Drlg. 2140'

2/23 Spud 2-5-55  
 D & A  
 TD 3621'  
 8" @ 100'  
 Anhy 1245', Heeb 3267' Lans 3313'  
 DST 3338'-58' opn 1 hr, rec 120' s.w.  
 875#  
 DST 3411'-30' opn 1 hr, rec 120' bcm  
 # Cong. 3558'  
 TD 3621'  
 D & A

**ABANDONED**



County Ellis State Kansas

Sec. 20 (Blk.) 13 (Sur.) 17W Map No. (Twp.) (Rge.)

Operator Glen R. Nye

Well No. 1 Farm Weber

Elev. 2032 Location SE NW SE



990 Ft. From N Line SE

990 Ft. From W Line Quarter

1st. Report

FEB 23 1955

Completion

Remarks

Co. tools

Spudding Date 2-5-55

Drilg. Data D & A TD 3621

8" @ 100 Anhy 1245 Heeb. 3267

Lans. 3313 DST 3338-58 open 1 hr.

Rec. 120' sw 875# DST 3411-30 open 1 hr.

Rec. 120' ocm 0# Cong. 3558 TD 3621

D & A

FABEN GILSTRAP