FORM 51 10M 2-49 PETROL


W. D. D. KANSAS Barton

Section 32 Township 17 Range 13-W

Well No. #1 Beetz

Company Herndon Drlg

Hoisington Pool

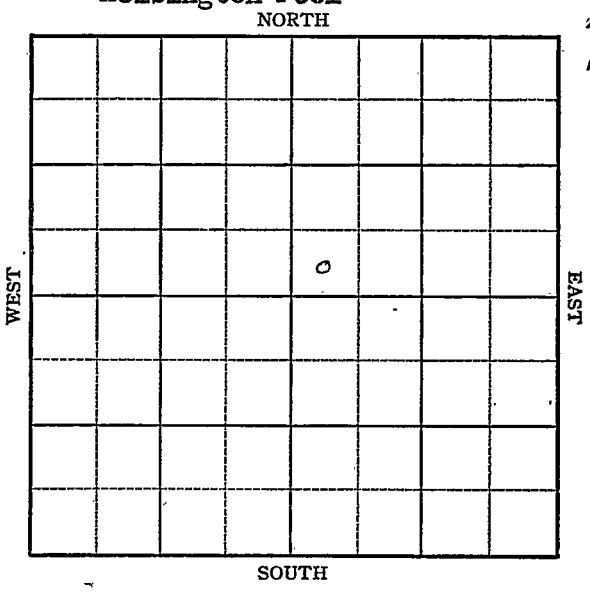

FORM 252-B
10M 9-49 PETROL

Barton KANSAS

Sec. 32 Twp. 17 R. 13W

Well No. #1 Beetz Farm

Herndon Drlg. Company

Herndon Contractor

Hoisington Pool O.W.D.D


____ Ft. from N. Line

330' Ft. from S. Line

____ Ft. from E. Line

330' Ft. from W. Line

SW NE

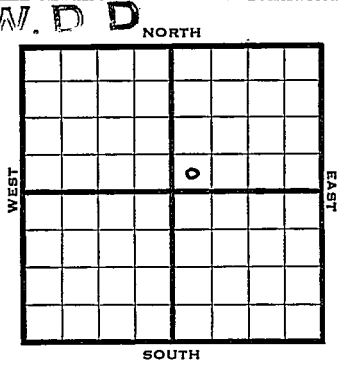

1949	Elev 1850 REPORT
11/9	8" @ 800'
11/16	Arb. 3330-39'
	TD 3339'
	5"@ 3331'
11/23	Lansing 3115'
11/29	TD 3345
	2000 acid
	Swb 3 bbls oil PH 3 hrs.
12/7	"
12/14	Pump40 bbls oil 24 hrs.
12/21	"
12/28	"
1950	
1/4	TD 3345'
	8"@ 800'
	Anhy 779'
	Arb. 3330'
	5"@ 3331'
	Br Lime 3099'
	Lans 3115'
	Cong 3320'
	2500 acid
	Pump 9 Oil
	No wtr.
	Comp

COMPLETED

OVER

O. W. D. D

1950

5/24 Lans. 3115'
Cong. 3320'
Arb. 3330'
OTD 3345'
5" @ 3331'
P 1 BOPD
DD 3355 500 A No inc
DD 3368 No inc

6/21 TD 3375
Lans 3115 Cong 3320
Arb3330
OTD 3345
5" @ 3331
500 acid
DD 3368
TD 3375 wtr
D&A

ABANDONED

Form 26 200 Bks. 6-49 Petrol

Kansas

Hoisington Pool

Map No. _____ Sec. 32 Twp. 17 R. 13W

Well No. 1 Beetz


Herndon Drlg. Company

Herndon Contractor

SW NE

FIRST REPORT

SECTION PLAT

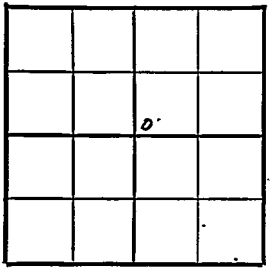

_____ Ft. from N. Line

330 Ft. from S. Line

_____ Ft. from E. Line

330 Ft. from W. Line

Barton County

Location _____

Rig up _____

Drilling and Remarks:

8" @ 800

RECORD

Cased _____ in., _____ ft.

Sand _____

Gas _____

Oil _____

Total Depth _____

PRODUCTION

1st 24 hrs. Nat. _____

1st 24 hrs. after shot _____

Gas _____ Cu. Ft.

Dry Hole _____

Abandoned _____

Date

NOV 9 1949 19 S I LEWIS Scout

Form 26 200 Bks. 6-49 Petrol

Kansas

Roland Pool

Map No. ____ Sec. 32 Twp. 17 R. 13W


Well No. 1 Beetz

Herndon Drlg. Company

Contractor

SW NE

SECTION PLAT

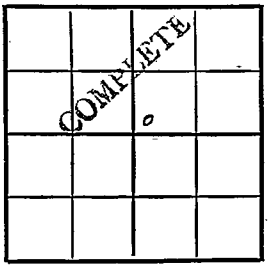

____ Ft. from N. Line

330 Ft. from S. Line

____ Ft. from E. Line

330 Ft. from W. Line

Barton County

Location

Rig up

Drilling and Remarks:

8" @ 800
Anhy 779
Arbl. 3330
5" @ 3331
Br. Lime 3099
Lans. 3115
Cong. 3320
2500 acid
Pump 9 bbl No water

RECORD

Cased ____ in., ____ ft.

Sand

Gas

Oil

Total Depth 3345

PRODUCTION

1st 24 hrs. Nat.

1st 24 hrs. after shot

Gas ____ Cu. Ft.

Dry Hole

Abandoned

Date

JAN 4 1950 19

J. E. Dyna Scout

Form 26 200 Bks. 11-49 Petrol

O. W. D. D

Kansas

Map No. _____ Sec. 32 Twp. 17 R. 13W


Well No. 1 Beetz

Hearndon Drlg. Company

Contractor

SW SW NE

SECTION PLAT

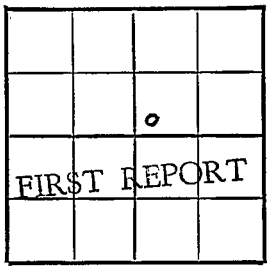

_____ Ft. from N. Line

330 Ft. from S. Line

_____ Ft. from E. Line

330 Ft. from W. Line

Barton OWDD

Location

Rig up

Drilling and Remarks:

Lans. 3115 /
Cong. 3320
Arb. 3330
OtD 3345
5"@ 3331
P10BOPD
DD3355 500A No inc
DD3368 No inc.

RECORD

Cased _____ in., _____ ft.

Sand

Gas

Oil

Total Depth

PRODUCTION

1st 24 hrs. Nat.

1st 24 hrs. after shot

Gas _____ Cu. Ft.

Dry Hole

Abandoned

Date

MAY 24 1950 19

J. E. TYRA Scout

Form 26 200 Bks. 11-49 Petrol

Kansas

OWDD

Map No. ____ Sec. 32 Twp. 17 R. 13W

Well No. 1 Boetz


Herndon Drlg. Company

Contractor

SWSW NE

El. 1850

SECTION PLAT

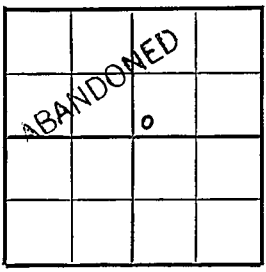

____ Ft. from N. Line

330 Ft. from S. Line

____ Ft. from E. Line

330 Ft. from W. Line

Barton County

Location ____

Rig up ____

Drilling and Remarks:

Lans. 3115
Cong. 3320
Arb. 3330
OTD 3345
5" @ 3331
DD 3355
500 acid
DD 3368

RECORD

Cased ____ in., ____ ft.

Sand ____

Gas ____

Oil ____

Total Depth 3375

PRODUCTION

1st 24 hrs. Nat. ____

1st 24 hrs. after shot ____

Gas ____ Cu. Ft.

Dry Hole ____

Abandoned ____

Date TD 3375 water

D & A

JUN 21 1950 19 J. E. TYRA Scout