


Section 32 Township 17 Range 13W

Well No. #1 Sausen

Company Petroleum Inc.

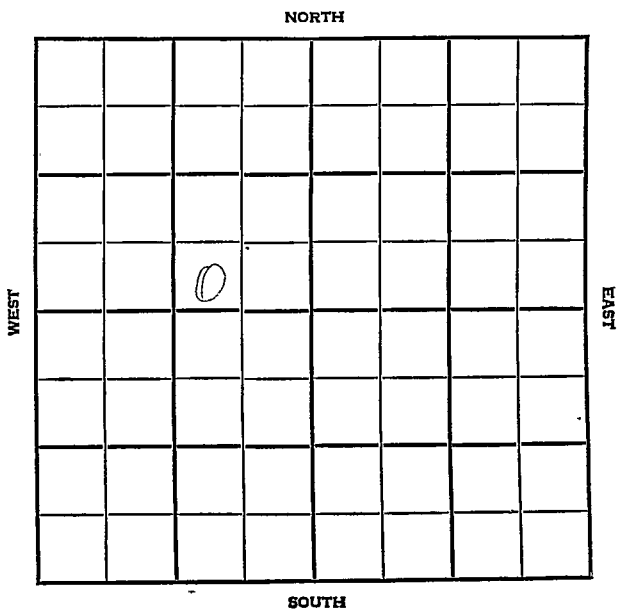


County Barton Elev. 1845
 Sec. 32 Twp. 17 Rgs. 13W
 Company Petroleum Inc.
 FarmName Sausen No. 1

Co.

TOPS	DEPTH	LOG	DATUM
Anh.			
TP.			
H.	3013		
Tr.	3029		
Dg.	3039		
Bl.	3095		
L.			
K.C.			
B.K.C.			
Ce.			
C.			
M.			
M.			
K.			
Mz.			
Me.			
V.			
S.			
S.			
A.			
R.			
PE.			
G.			
T.D.			

Loc. in Sec. SW SE NW
 Geol. _____
 Contr. _____
Carvey Tools
 Pool _____
Rowland

Lse.

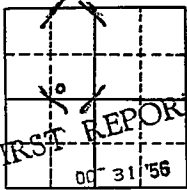

No.

Date Comm. spd. 10-24-56
8" @ 408 w/250, Old well abd.

Sec.

T.

R.

10.11

[Handwritten signature and scribbles]

County Barton Elev. 1845
 Sec. 32 Twp. 17 Rge. 13W
 Company Petroleum Inc.
 Farm Name Sausen No. 1

TOPS	DEPTH	LOG	DATUM	Loc in Sec.
Anh.				SW SE NW
TP.				
H.	3013			
Tr.	3029			
Dg.	3039			
Bl.	3095			
L.	3110			
K.C.				Geol.
B.K.C.				Contr.
Ce.				
C.	3316			Garvey Tools
M.				
M.				Pool
K.				Rowland
Mz.				
Mo.				
V.				
S.				
S.				
A.	3335			
R.				
Pe.				
G.				
TD.	3379			ABANDONED

Date Comm. spd. 10-24-56

8" @ 408 w/250, Old well abd. NOV 7 '56

DST 3120-80 1hr 25' Md BHP
 0 DST 3180-3210 1hr 12' Md
 BHP 300 DST 3228-3310 1hr
 120' w/250 BHP 430 DST 3310-35
 1hr 10' Md (Rn6500) BHP 330
 DST 3335-45 1hr 20' SCM BHP
 250

D & A