


Map No. Kansas Sec. 17 Twp. 33 R. 3Well No. 1 Thurlow FarmWaite Phillips Company

NORTH

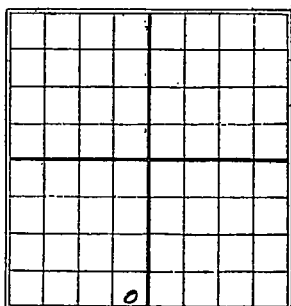

SOUTH

_____ Ft. from N. Line

330 Ft. from S. Line330 Ft. from E. Line

_____ Ft. from W. Line

Date

REPORT

19259/17 Location9/169/2419269/17 I.S. 3203

I.D. 2333

325 bbls

Cowley **KANSAS** K1
 Map No. _____ Sec. 17 Twp. 33 R. 3

Well No. 1 Thurlow, A
Watte Phillips Company

Contractor

SECTION PLAT

_____ Ft. from N. Line

330 Ft. from S. Line

330 Ft. from E. Line

_____ Ft. from W. Line

FIRST REPORTS

Location ✓

Rig up _____

Drilling and Remarks:

RECORD

Cased _____ in., _____ ft.

Sand _____

Gas _____

Oil _____

Total Depth _____

PRODUCTION

1st 24 hrs. Nat. _____

1st 24 hrs. after shot _____

Gas _____ Cu. Ft.

Dry Hole _____

Abandoned _____

Date

SEP 2 1925

S. J. LEWIS

Scout

County County
Map No. KANSAS Sec. 17 Twp. 33 R. 3EWell No. 1 ThuklowWaite Phillips Company

Contractor

SECTION PLAT

Ft. from N. Line

330 Ft. from S. Line330 Ft. from E. Line

Ft. from W. Line

COMPLETED

Location

Rig up

Drilling and Remarks:

W. 3203W. 32333233 1/2

RECORD

Cased _____ in., _____ ft.

Sand _____

Gas _____

Oil _____

Total Depth _____

PRODUCTION

1st 24 hrs. Nat. _____

1st 24 hrs. after shot _____

Gas _____ Cu. Ft.

Dry Hole _____

Abandoned _____

Date

SEP 17 1926

S. J. LEWIS Scout