


KANSAS

Map No. _____ Sec. 5 Twp. 12 R. 15^W

Well No. 3 Keleman Farm
Lew Johnson et al Company

NORTH

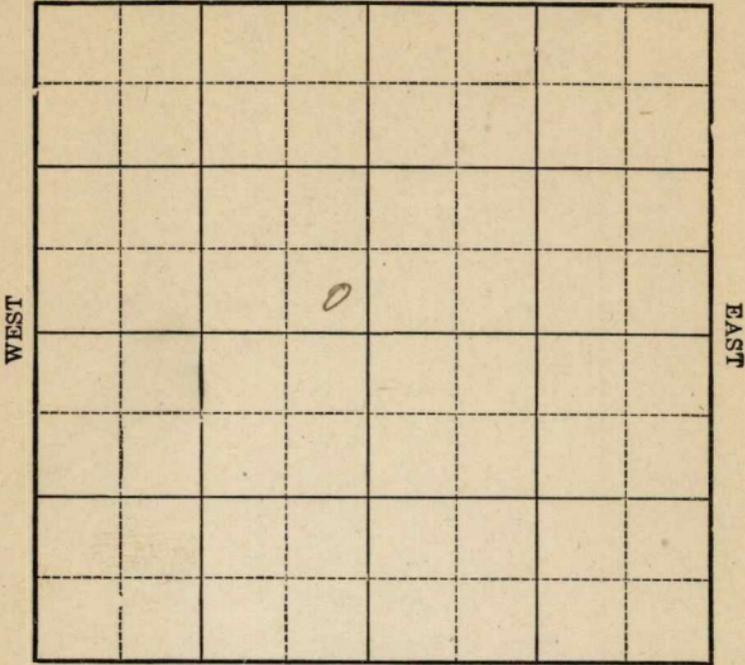

SOUTH

Location _____

Drilling Remarks _____

Rig Up _____

Drilling Remarks _____

RECORD

Cased _____ in. _____ ft.

Sand _____

Gas _____

Oil _____

Total Depth _____

PRODUCTION

1st 24 hrs. Nat. _____

1st. 24 hrs. after shot _____

Gas _____ cu. ft.

Dry Hole _____

Abandoned _____

Russell

Map No. **KANSAS** Sec. 5 Twp. 12 R. 15 W

Well No. 3 Kelenan

Tom Johnson & Co Company

Contractor

FIRST REPORT

SECTION PLAT

----- Ft. from N. Line

200 Ft. from S. Line

200 Ft. from E. Line

----- Ft. from W. Line

		0	

Location -----

Rig up -----

Drilling and Remarks:

R.O.G.

RECORD

Cased ----- in., ----- ft.

Sand -----

Gas -----

Oil -----

Total Depth -----

PRODUCTION

1st 24 hrs. Nat. -----

1st 24 hrs. after shot -----

Gas ----- Cu. Ft.

Dry Hole -----

Abandoned -----

Date

AUG 1 2 1925

192

S. J. LEWIS

Scout

No Map

Russell

Map No. KANSAS Sec. 5 Twp. 12 R. 15W

Well No. 3 Kollman

J.C. Johnson Company

Contractor

SECTION PLAT

		0	

----- Ft. from N. Line

200 Ft. from S. Line

200 Ft. from E. Line

----- Ft. from W. Line

COMPLETED

Location -----

Rig up -----

Drilling and Remarks:

TS 2784
BS 2788

15876 per se

RECORD

Cased ----- in., ----- ft.

Sand -----

Gas -----

Oil -----

Total Depth -----

PRODUCTION

1st 24 hrs. Nat. -----

1st 24 hrs. after shot -----

Gas ----- Cu. Ft.

Dry Hole -----

Abandoned -----

Date

OCT 21 1925

S. J. LEWIS

Scout