


NORTH

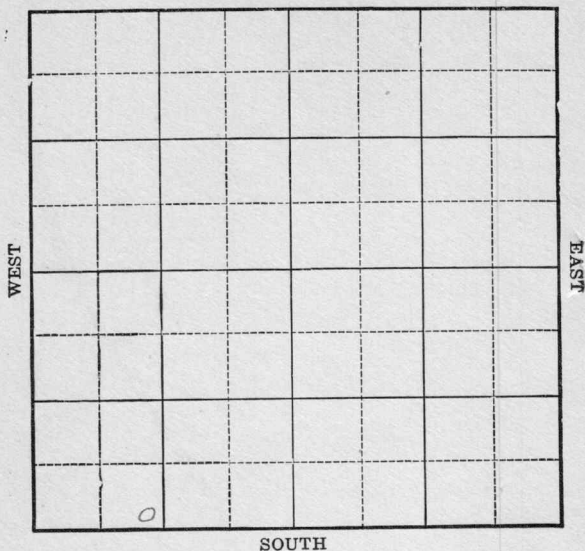

PRODUCTION

1st 24 hrs. Nat. _____

1st 24 hrs. after shot _____


Gas _____ cu. ft.

Dry Hole _____

Abandoned _____

 Well No. *8 H J hurlow* Farm
Waite P hillips Company

_____ Ft. from N. Line
330 Ft. from S. Line
 _____ Ft. from E. Line
990 Ft. from W. Line

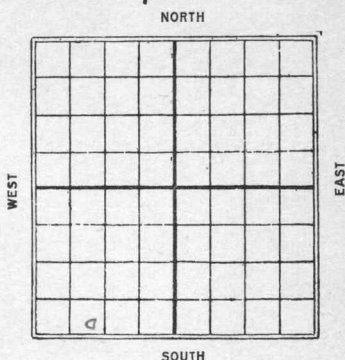

1996

REPORT

1/3 Rig Bldg.
4/14 Top sand 3189
 Gas 3193 Oil 3199
 T.D. 3212 30 bbls nat
 Shot 10 gts 125 bbls

Country *Cowley*
 Map No. **KANSAS** Sec. *16* Twp. *33* R. *2E*

Well No. *J. H. Thurston*

Waite Phillips Company

Contractor

SECTION PLAT

_____ Ft. from N. Line

330 Ft. from S. Line

_____ Ft. from E. Line

990 Ft. from W. Line

<i>0</i>			

FIRST REPORTS

Location _____

Rig up _____

Drilling and Remarks:

Rig Bldg

RECORD

Cased _____ in., _____ ft.

Sand _____

Gas _____

Oil _____

Total Depth _____

PRODUCTION

1st 24 hrs. Nat. _____

1st 24 hrs. after shot _____

Gas _____ Cu. Ft.

Dry Hole _____

Abandoned _____

Date

JAN 13 1926
 192

S. J. LEWIS

Scout

K1
 Map No. **KANSAS** Sec. *16* Twp. *33* R. *3E*

Well No. *8 H. T. Purlow*

Haite Phillips Company

Contractor

SECTION PLAT

_____ Ft. from N. Line

330 Ft. from S. Line

_____ Ft. from E. Line

990 Ft. from W. Line

<i>0</i>			

COMPLETED

Location _____

Rig up _____

Drilling and Remarks:

T.B. 3189

Gas 3193

Oil 3199

T.D. 3212

3088 lb. Vals.

Shot 109 lbs.

12588 lb.

RECORD

Cased _____ in., _____ ft.

Sand _____

Gas _____

Oil _____

Total Depth _____

PRODUCTION

1st 24 hrs. Nat. _____

1st 24 hrs. after shot _____

Gas _____ Cu. Ft.

Dry Hole _____

Abandoned _____

Date

APR 14 1926

192

S. J. LEWIS

Scout