


Russell

Form 51-5M-5-34-Palace

Map No. **KANSAS** Sec. 5 Twp. 12 R. 15 ^W

Well No. 3-A Sutton Farm
Central Pet & Johnson Company

NORTH

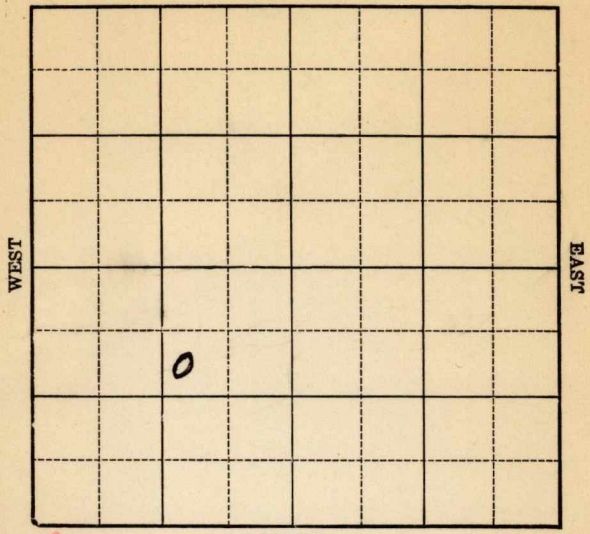

No Record

SOUTH

OWDD

Location _____
Drilling Remarks _____

Rig Up _____
Drilling Remarks _____

RECORD


Cased _____ in. _____ ft.
Sand _____
Gas _____
Oil _____
Total Depth _____

PRODUCTION

1st 24 hrs. Nat. _____
1st 24 hrs. after shot _____
Gas _____ cu. ft.
Dry Hole _____
Abandoned _____

Central Pet & Johnson Company

Ft. from W. Line

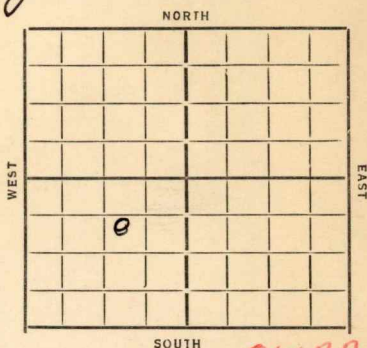

No Record

OWNDD

Date 1934

REPORT

8/22 0 TD 2284 Rgn up
8/30 — 9/5 — 9/13 — 9/20 —
9/27 — 10/4 —
10/11 Dly 2315
10/18 5 3/16 2450 WR 2510
10/25 750' oil 2684-90 WR 5"
11/1 5" 2673 2690 C.O.
11/8 S.O. 2684-90 TD 2748
500 acid No results
Asphalt 2753 TD 2754
600' oil
11/15 5" 2765 Oil 2785-95
1000 acid 30 oil + 8 w 8 hrs.
11/21 TD 2809 1000 acid
42 oil 30 water

COMPLETED

Map No. 72 Sec. 5 Twp. 12 R. 15ⁿWell No. 3A - SuttonCentral pet + Johnson Company

Contractor

SECTION PLAT

890 Ft. from N. Line

_____ Ft. from S. Line

1090 Ft. from E. Line

_____ Ft. from W. Line

FIRST REPORTS

Location _____

RECORD

Cased _____ in., _____ ft.

Sand _____

Gas _____

Oil _____

Total Depth _____

PRODUCTION

1st 24 hrs. Nat. _____

1st 24 hrs. after shot _____

Gas _____ Cu. Ft.

Dry Hole _____

Abandoned _____

Date

8-27-34 19

ORVAL MANNSCHRECK Scout

I do not have
record of old
well.

KANSAS

Map No. 72 Sec. 5 Twp. 12 R. 15WWell No. 3A - SuttonCentral pet + Johnson Company

Contractor

COMPLETED

SECTION PLAT

890 Ft. from N. Line

Ft. from S. Line

1090 Ft. from E. Line

Ft. from W. Line

QWDD

Location _____

Rig up _____

Drilling and Remarks:

1000 acid42 oil
30 water

RECORD

Cased _____ in., _____ ft.

Sand _____

Gas _____

Oil _____

Total Depth 2809

PRODUCTION

1st 24 hrs. Nat. _____

1st 24 hrs. after shot _____

Gas _____ Cu. Ft.

Dry Hole _____

Abandoned _____

Date

11-21-34 19

ORVAL MANNSCHRECK

Scout