


Map No. Kansas Sec. 5 Twp. 12 R. 15^W
Well No. 6 Kollman Farm
J. C. Johnson Company

NORTH

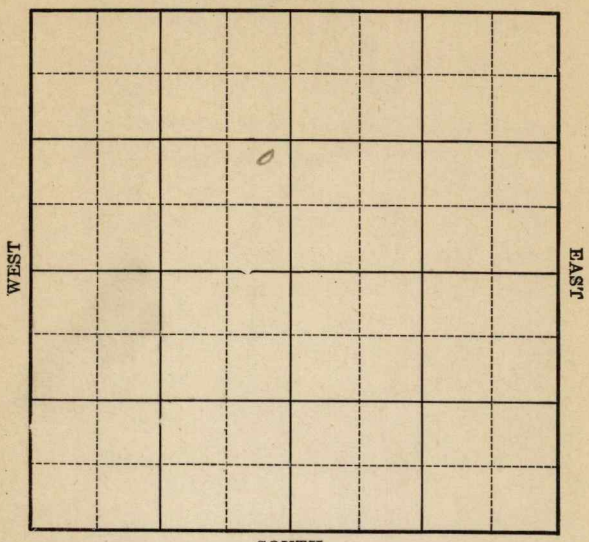

SOUTH

Location _____
Drilling Remarks _____

Rig Up _____
Drilling Remarks _____

RECORD

Cased _____ in. _____ ft.
Sand _____
Gas _____
Oil _____
Total Depth _____

PRODUCTION

1st 24 hrs. Nat. _____
1st 24 hrs. after shot _____
Gas _____ cu. ft.
Dry Hole _____
Abandoned _____

Map No. Russell Kansas Sec. 5 Twp. 12 R. 15^W


Well No. 6 Kollman Farm
J. C. Johnson Company

_____ Ft. from N. Line

990 Ft. from S. Line

300 Ft. from E. Line

_____ Ft. from W. Line

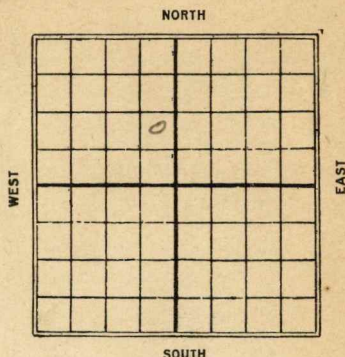

Date

REPORT

1925

12/16

Rig

1926

2/16

Top sand 2881 T.D. 2884
7 Bbls per hour Swabbing

home **KANSAS**

Map No. _____ Sec. 5 Twp. 12 R. 10 WWell No. 6 KollmanJ. C. Johnson Company_____
Contractor

SECTION PLAT

	0		

_____ Ft. from N. Line

990 Ft. from S. Line300 Ft. from E. Line

_____ Ft. from W. Line

COMPLETED

Location _____

Rig up _____

Drilling and Remarks:


RECORD

Cased _____ in., _____ ft.

Sand _____

Gas _____

Oil _____

Total Depth _____

PRODUCTION

1st 24 hrs. Nat. _____

1st 24 hrs. after shot _____

Gas _____ Cu. Ft.

Dry Hole _____

Abandoned _____

Date

FEB 16 1926S. J. LEWIS_____
Scout

Map No. KANSAS Sec. 5 Twp. 12 R. 15W

Well No. 6. Hollman

T. C. Johnson Company

Contractor

SECTION PLAT

----- Ft. from N. Line

990 Ft. from S. Line

300 Ft. from E. Line

----- Ft. from W. Line

	0		

FIRST REPORTS

Location -----

Rig up -----

Drilling and Remarks:

Rig.

RECORD

Cased ----- in., ----- ft.

Sand -----

Gas -----

Oil -----

Total Depth -----

PRODUCTION

1st 24 hrs. Nat. -----

1st 24 hrs. after shot -----

Gas ----- Cu. Ft.

Dry Hole -----

Abandoned -----

Date

DEC 16 1925

192

S. J. LEWIS

Scout