


Map No. Kansas Sec. 5 Twp. 12 R. 15W
Well No. 7 Kelman. Farm _____
J. Johnson. Company _____

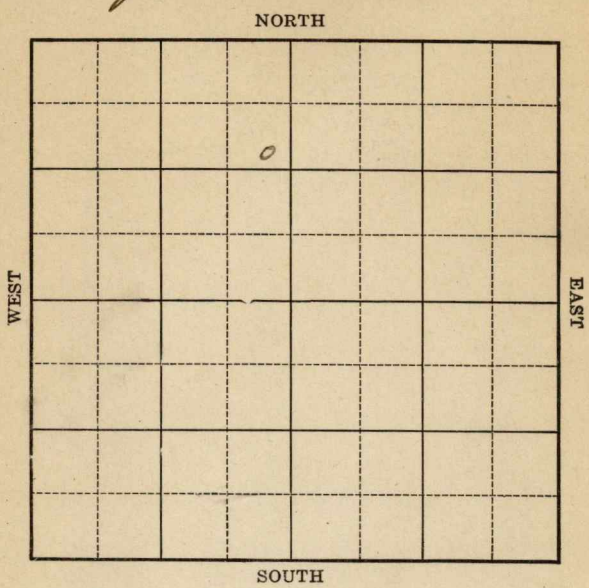

Location _____
Drilling Remarks _____

Rig Up _____
Drilling Remarks _____

RECORD


Cased _____ in. _____ ft.
Sand _____
Gas _____
Oil _____
Total Depth _____

PRODUCTION

1st 24 hrs. Nat. _____
1st 24 hrs. after shot _____
Gas _____ cu. ft.
Dry Hole _____
Abandoned _____

Map No. Kansas Sec. 5 Twp. 12 R 15^w
 Well No. 7. Kolman Farm
J. Johnson Company

NORTH

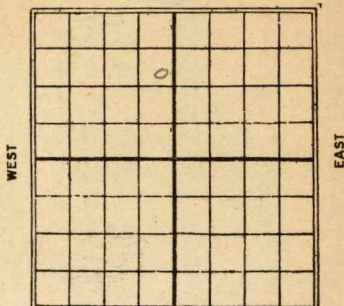

990 Ft. from N. Line

_____ Ft. from S. Line

300 Ft. from E. Line

_____ Ft. from W. Line

SOUTH

Date

REPORT

1926
3/17 Rig
4/14 Log 2300
4/21 " 2510
4/29 " 2755.
5/5 Sand 2805-2815
100 bbls nat

Map No. *no map* **KANSAS** Sec. *5* Twp. *12* R. *15W*

Well No. *7 Holman*

T. Johnson Company

Contractor

SECTION PLAT

990 Ft. from N. Line

----- Ft. from S. Line

300 Ft. from E. Line

----- Ft. from W. Line

	0		

FIRST REPORTS

RECORD

Location -----

Rig up -----

Drilling and Remarks:

Rig

Cased ----- in., ----- ft.

Sand -----

Gas -----

Oil -----

Total Depth -----

PRODUCTION

1st 24 hrs. Nat. -----

1st 24 hrs. after shot -----

Gas ----- Cu. Ft.

Dry Hole -----

Abandoned -----

Date

MAR 17 1926

S. J. LEWIS

Scout

Map No. KANSAS Sec. 5 Twp. 12 R. 15 N

Well No. 7 Holman

T. Johnson Company

Contractor

SECTION PLAT

990 Ft. from N. Line

_____ Ft. from S. Line

300 Ft. from E. Line

_____ Ft. from W. Line

	0		

COMPLETED

Location _____

Rig up _____

Drilling and Remarks:

Sand 2800 ft
2815.

100 x 1/2
Nat.

RECORD

Cased _____ in., _____ ft.

Sand _____

Gas _____

Oil _____

Total Depth _____

PRODUCTION

1st 24 hrs. Nat. _____

1st 24 hrs. after shot _____

Gas _____ Cu. Ft.

Dry Hole _____

Abandoned _____

Date

MAY 5 - 1926

192

S. J. LEWIS

Scout