


Map No. Kansas Sec. 17 Twp. 33 R. 3E

Well No. 2 Shurlow Farm
White Phillips Company

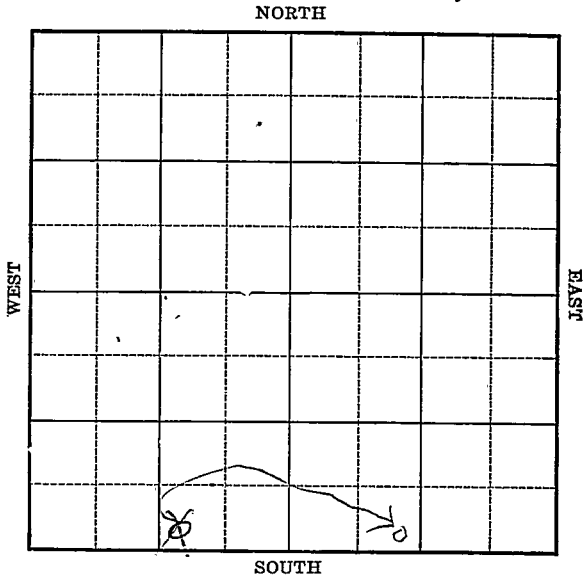

Location _____

Drilling Remarks

RECORD

Cased _____ in. _____ ft.

Sand _____

Gas _____

Oil _____

Total Depth _____

Rig Up _____

Drilling Remarks

PRODUCTION

1st 24 hrs. Nat. _____

1st 24 hrs. after shot _____

Gas _____ cu. ft.

Dry Hole _____

Abandoned _____

Map No. Kan Sec. 17 Twp. 33 R. 3

Well No. 2 A Jhurlow Farm
Waite-Phillips Company


_____ Ft. from N. Line

330 Ft. from S. Line

_____ Ft. from E. Line

990 Ft. from W. Line

B

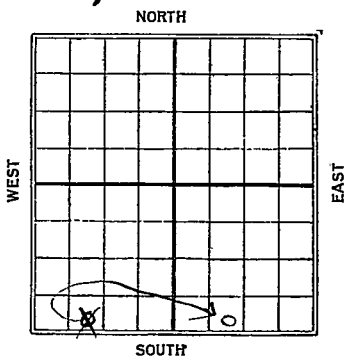

Date	REPORT
<u>7/22</u>	<u>Location</u>
<u>7/29</u>	<u>set 15 1/2" 183</u>
<u>8/7</u>	<u>800'</u>
<u>8/14</u>	<u>set 10" @ 1765</u>
<u>8/19</u>	<u>1970'</u>
<u>8/27</u>	<u>2277'</u>
<u>9/2</u>	<u>2760'</u>
<u>9/9</u>	<u>2860'</u>
<u>9/16</u>	<u>U.R. 6" T.D. 2975'</u>
<u>9/24</u>	<u>Tap sand 3177 - set 5" - 2 M Log</u>
<u>#</u>	
<u>9/30</u>	<u>3 3177 Gas 3178 Oil 3185</u>
	<u>Btm sand 3201</u>
	<u>T.D. 3202 383 Bbls</u>

1 *Cowley*
 Map No. **KANSAS** Sec. 17 Twp. 33 R. 3E

Well No. 2 Thurlow A

Watte Phillips Company

Contractor

SECTION PLAT

----- Ft. from N. Line

620 Ft. from S. Line

990 Ft. from E. Line

----- Ft. from W. Line

FIRST REPORTS

Location ✓-----

Rig up -----

Drilling and Remarks:

RECORD

Cased ----- in., ----- ft.

Sand -----

Gas -----

Oil -----

Total Depth -----

PRODUCTION

1st 24 hrs. Nat. -----

1st 24 hrs. after shot -----

Gas ----- Cu. Ft.

Dry Hole -----

Abandoned -----

Date

SEP 2 1925

192

S. J. LEWIS

Scout

Map No. KANSAS Sec. 17 Twp. 33 R. 3E

Well No. 2 H. Thurlow

White Phillips Company

Contractor

SECTION PLAT

			0

----- Ft. from N. Line

330 Ft. from S. Line

----- Ft. from E. Line

990 Ft. from W. Line

COMPLETED

Location -----

Rig up -----

Drilling and Remarks:

T.S. 3177
Gas 3178
Oil 3185
B.S. 3201
VII 3202.
383 H/L.

RECORD

Cased ----- in., ----- ft.

Sand -----

Gas -----

Oil -----

Total Depth -----

PRODUCTION

1st 24 hrs. Nat. -----

1st 24 hrs. after shot -----

Gas ----- Cu. Ft.

Dry Hole -----

Abandoned -----

Date

SEP 30 1925

S. J. LEWIS

Scout