


Section 20 Township 13 Range 3W

Well No. #1 Craig

Company Rupp-Ferguson

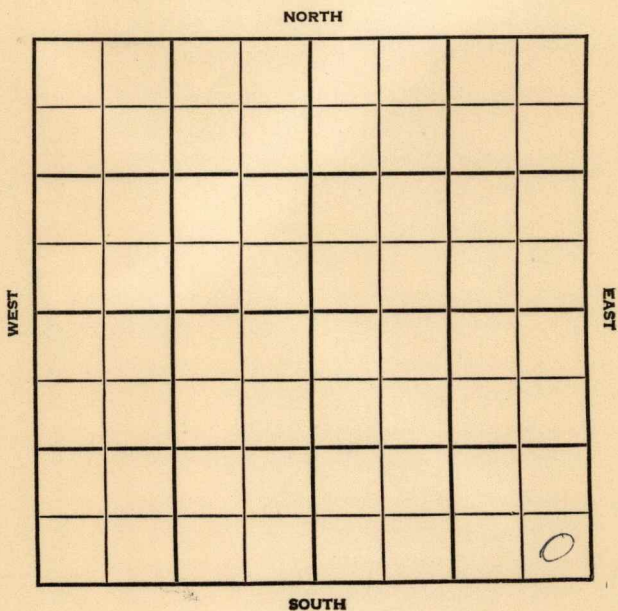

WILDCAT

FORM 513 SUNRAY

County Saline Elev. _____
 Sec. 20 Twp. 13 Rgs. 3W
 Company Rupp-Ferguson
 Farm Name Craig No. 1

TOPS	DEPTH	LOG	DATUM	Loc. in Sec.
Anh.				SE SE SE
Tr.				
Dg.				
Bl.				
L.				
K.C.				Geol. _____
B.K.C.				Contr. _____
Ce.				Co. Tools
C.				
M.				Pool
M.				Wildcat
K.				
Mz.				
Me.				
V.				
S.				
S.				
A.				
R.				
Pe.				
G.				
T.D.				

NOV 28 1956
 FIRST REPORT

Date Comm. Phillips DHM
MIRT

Co.
Lse.
No.
Sec.
T.
R.

Co.

County Saline Elev. 1231
 Sec. 20 Twp. 13 Rge. 3W
 Company Rupp-Ferguson
 Farm Name Craig No. 1

TOPS	DEPTH	LOG	DATUM	Loc. in Sec.
Anh.				SE SE SE
TP.				
H.		1999		
Tr.		2022		
Dg.		2042		
Bl.				
L.		2194		Geol.
K.C.				Contr.
R.K.C.		2544		
Ce.				Co. Tools
e. <u>Marm</u>		2556		
M. <u>ce</u>		2697		
M.		2877		Pool
K.		29204		Wildcat
M. <u>HUNT</u>		3326		ABANDONE
M. <u>54V</u>		3428		
V.		3526		
S. <u>Dolo</u>		3636		
S. <u>sd</u>		3641-65		
A.		3732		
R.				
PE.				
G.				
TD	3769			

Date Comm. Phillips DHM
MIRT DEC 5 '56 11-27-56 # 13 3/8
105/200 878 286/140 # 2025
DEC 12 '56 # 2650 DEC 19 '56

DEA