


Map No. **KANSAS** Sec. 17 Twp. 33 R. 3
Well No. 4 H. J. Thurlow Farm
Walter P. Phillips Company

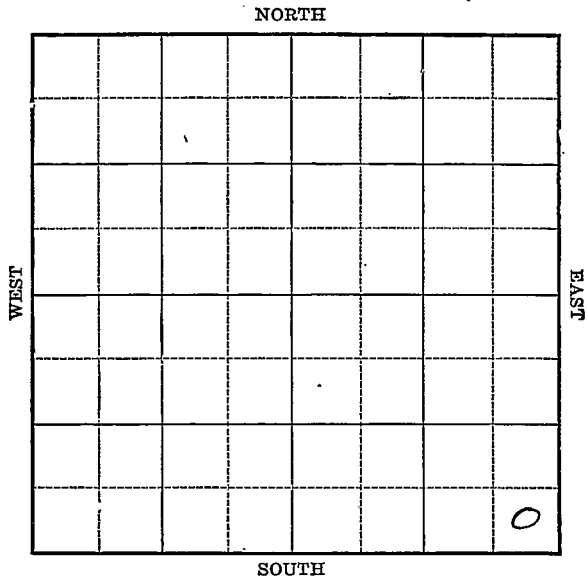

Location _____

Drilling Remarks _____

Rig Up _____

Drilling Remarks _____

RECORD

Cased _____ in. _____ ft.

Sand _____

Gas _____

Oil _____

Total Depth _____

PRODUCTION

1st 24 hrs. Nat. _____

1st. 24 hrs. after shot _____

Gas _____ cu. ft.

Dry Hole _____

Abandoned _____

Map No. KANSAS Sec. 17 Twp. 33 R. 3E

Well No. #4 H. Thurlow

Waite Phillips Company

Contractor

FIRST REPORT

SECTION PLAT

----- Ft. from N. Line

330 Ft. from S. Line

336 Ft. from E. Line

----- Ft. from W. Line

			0

Location -----

Rig up -----

Drilling and Remarks:

Cellar.

RECORD

Cased ----- in., ----- ft.

Sand -----

Gas -----

Oil -----

Total Depth -----

PRODUCTION

1st 24 hrs. Nat. -----

1st 24 hrs. after shot -----

Gas ----- Cu. Ft.

Dry Hole -----

Abandoned -----

Date

AUG 5 1905

J. Lewis Scout

K1
 Map No. **KANSAS** Sec. 17 Twp. 33 R. 3E
 Well No. H. H. Thurston
Waite Phillips Company
 Contractor

SECTION PLAT

-----Ft. from N. Line.

330 Ft. from S. Line

330 Ft. from E. Line

-----Ft. from W. Line

			0

COMPLETED

Location -----

Rig up -----

Drilling and Remarks:

T.B. 3174

B.B. 3202

225 Hls. Nat.

RECORD

Cased ----- in., ----- ft.

Sand -----

Gas -----

Oil -----

Total Depth -----

PRODUCTION

1st 24 hrs. Nat. -----

1st 24 hrs. after shot -----

Gas ----- Cu. Ft.

Dry Hole -----

Abandoned -----

Date

OCT 13 1925

S. J. LEWIS

Scout

192