


Saline

Form 51-5M-2-29-34703

Map No. **KANSAS** Sec. 20 Twp. 13 R. 4^W

Well No. 1- Hughes Farm
Kenney Substal Company

NORTH

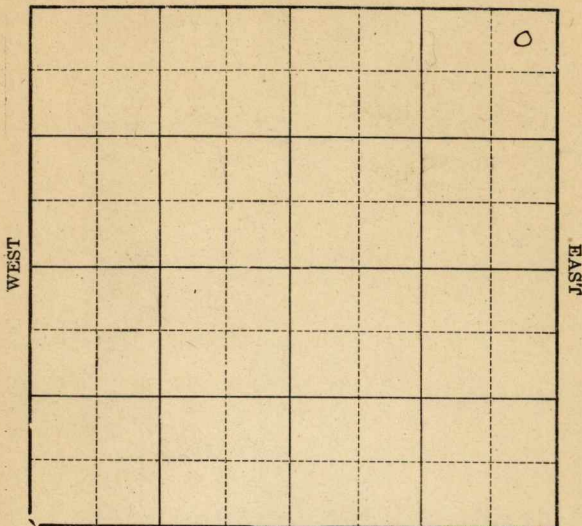

SOUTH

Location

Drilling Remarks

Rig Up

Drilling Remarks

RECORD

Cased in. ft.

Sand

Gas

Oil

Total Depth

PRODUCTION

1st 24 hrs. Nat.

1st 24 hrs. after shot

Gas cu. ft.

Dry Hole

Abandoned

Saline

Map No. **KANSAS** Sec. 20 Twp. 13 R. 4^w


Well No. 1- Hughes Farm
Kenney - Postal Company

330 Ft. from N. Line

_____ Ft. from S. Line

330 Ft. from E. Line

_____ Ft. from W. Line

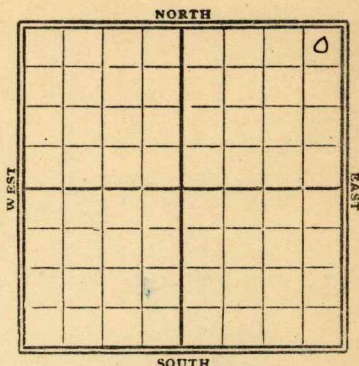

1929

Date	REPORT
4/10	Roq
4/16	Reg
4/24	Spud & S.D.
5/1	_____
5/8	_____ 9/11 - S.D. 600
5/14	_____ 9/18 _____
5/22	_____ 9/25 _____
5/29	_____ 10/2 _____
6/5	_____ 10/9 _____
6/12	_____ 10/16 _____
6/19	_____ 10/23 _____
6/26	_____ 10/30 _____
7/2	_____ 11/6 _____
7/10	_____ 11/13 _____
7/17	_____ 11/20 _____
7/24	_____ 11/27 _____
7/31	_____ 11/24 _____
8/7	Spdy 160 12/11 _____
8/14	" 250 12/18 _____
8-21	Reg 510 12/23 _____
8-28	no Report 12/30 _____
9/4	_____

1930

1/8- S.D. 600'

1/15 —

1/22 —

1/29- T.D. 600'

Dry & Abandon

Map No. **KANSAS** Sec. 20 Twp. 13 R. 4W

Well No. 52 1 Hughes

Kennedy Contract Company

Contractor

SECTION PLAT

330 Ft. from N. Line

_____ Ft. from S. Line

330 Ft. from E. Line

_____ Ft. from W. Line

			0

ABANDONED

Location _____

Rig up _____

Drilling and Remarks:

RECORD

Cased _____ in., _____ ft.

Sand _____

Gas _____

Oil _____

Total Depth 600

PRODUCTION

1st 24 hrs. Nat. _____

1st 24 hrs. after shot _____

Gas _____ Cu. Ft.

Dry Hole _____

Abandoned _____

Date

JAN 29 1930

192

S. J. LEWIS

Scout

Map No. **KANSAS** Sec. 20 Twp. 13 R. 7W
 Well No. Hughes

Kenney Crystal Company

Contractor

SECTION PLAT

320 Ft. from N. Line

..... Ft. from S. Line

330 Ft. from E. Line

..... Ft. from W. Line

			0

FIRST REPORTS

Location.....

Rig up.....

Drilling and Remarks:

ROG

RECORD

Cased..... in., ft.

Sand.....

Gas.....

Oil.....

Total Depth.....

PRODUCTION

1st 24 hrs. Nat.....

1st 24 hrs. after shot.....

Gas..... Cu. Ft.

Dry Hole.....

Abandoned.....

Date

APR 10 1929

192

S. J. LEWIS

Scout