

Barton

KANSAS

SECTION 33 TOWNSHIP 17 RANGE 13 W

WELL NO. #3 O. A. French

COMPANY Skelly Oil

NORTH

WEST

EAST

SOUTH

O

184

Barton

KANSAS

SEC.	TWP.	R.
33	17	13W

WELL NO.

#3 O. A. French

FARM

COMPANY

Skelly Oil Co.

CONTRACTOR

Wentworth

Herres


Ft. from N. Line

Ft. from S. Line

Ft. from E. Line

Ft. from W. Line

NE SE SW

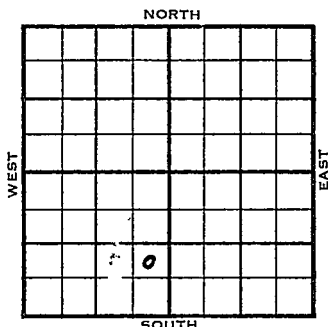

1955

ELEVATION

1858'

REPORT

10/26

Location

12-14

Comm. 10-26-55

8 5/8" @ 789/450

5 1/2" @ 3339

DD 3350

1 boph 2 hrs., 300 A

S/ 20 13 hrs., 500 A

S/ 16 bo 12 bw 12 hrs.

DD 3353, 1000 A

S/ 15 bo 11 bw 9 hrs.

DD 3358

S/ 17 bo 3 bw 16 hrs., 1500 A

S/ 12 bo, 15 baw 6 hrs.

P/ 20 bo 20 bw 20 hrs.

Comp. 25 bopd, 37 bw

Anh. 780

H. 3019

Tr. 3034

Dg. 3048

BL. 3106

L. 3118

A 3337

TD 3340

COMPLETED

County Barton Elev. _____
 Sec. 33 Twp. 17 Rge. 13W
 Company Skelly Oil
 Farm Name O. A. French No. 3

TOPS

DEPTH

LOG

DATUM

Loc. in Sec. _____

Anh.

Tp.

H.

Tr.

Dg.

Bl.

L.

K.C.

B.K.C.

Ce.

C.

M.

M.

K.

Mz.

Ma.

V.

S.

S.

A.

R.

P.E.

G.

T.D.

Geol. _____

Contr. _____

Wentworth

Pool _____

Herres

OCT 26 1955

FIRST REPORT

Date Comm. _____

Location

Co.

Loc.

No.

Sec.

T.

R.

County Barton Elev. 1858
 Sec. 33 Twp. 17 Rge. 13W
 Company Skelly Oil
 Farm Name O. A. French No. 3

TOPS	DEPTH	LOG	DATUM	Loc. in Sec.
Anh.	780			NE SE SW
Tr.				
H.	3019		1161	
Tr.	3034		1176	
Dg.	3048		1190	
Bl.	3106		1248	
L.	3118		1260	
K.C.				Geol.
B.K.C.				Contr.
Ce.				Wentworth
C.				Pool
M.				Herres
M.				
K.				
Mz.				
Ma.				
V.				
S.				
S.				
A.	3337		1479	
R.				
Pe.				
G.				
TD.	3340			

Date Comm. 10-26-55 DEC 1 4 1955

8 5/8" @ 789/450 5 1/2" @ 3339

DD 3350 1 boph 2 hr. 300 A

S/ 20 13 hr. 500 A S/ 16 bo

12 bw 12 hr. DD 3353 1000 A

S/ 15 bo 11 bw 9 hr. DD 3358

S/ 17 bo 3bw 16 hr. 1500 A

S/ 12 bo 15 baw 6 hr.

P/ 20 bo 20 bw 20 hr.

Comp. 25 bopd 37 b w

COMPLETE