

O. W. D. D.

Barton

KANSAS

Section 33 Township 17 Range 13 WWell No. #4 O. A. French #3 Herres SWDCompany Skelly Oil

NORTH

13

WEST

EAST

Q							

SOUTH

O. W. D. D. Barton

KANSAS

SEC. 33	TWP. 17	R. 13W
------------	------------	-----------

WELL NO.

#4 ~~O.A. French~~ #3 Herres SWD FARM

COMPANY

Skelly Oil

CONTRACTOR

Wentworth

Herres


_____ Ft. from N. Line

_____ Ft. from S. Line

_____ Ft. from E. Line

_____ Ft. from W. Line

NW SW SW

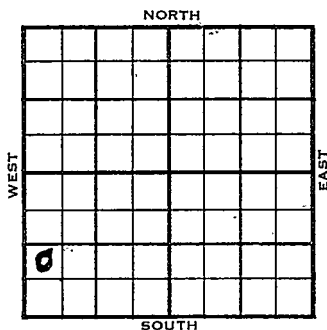

1956

ELEVATION

1861'

REPORT

3-7

Location

5-2

Comm. 3-16-56

8 5/8" @ 799 w/450

5 1/2" @ 3336 w/125

DD 3345

B/ 12 goph, 1 1/2 hr., 250 A, 750 A

S/ 23 bo, 3 bw 10 hrs.

DD 3349

S/ 9 bo, 2 bw 4 hrs.,

DD 3353

S/ 9 bo, 4 bw, 6 hrs., 1250A

P/ 40 bo, 24 hrs.

Comp. 85 bopd

Anh. 791

H. 3025

Tr. 3041

Dg. 3054

BL. 3108

L. 3122

A. 3336

TD 3337'

COMPLETED

1956

O. W. D. D.

5-29 OTD 3373
5" @ 3372
sq/ 3330-36
DD 3638
CO 3638
Comp. SWD well , 157 bw, 42 min.
A. 3330'

FIRST REPORT



ABANDONED

County	Barton	Elev.	
Sec.	33	Twp.	17
		Rge.	13W
Company	Skelly Oil		
Farm Name	O. A. French		No. 4

TOPS	DEPTH	LOG	DATUM
Anh.			
Tp.			
H.			
Tr.			
Dg.			
Bl.			
L.			
K.C.			
B.K.C.			
Ce.			
C.			
M.			
M.			
K.			
Mz.			
Mq.			
V.			
S.			
S.			
A.			
R.			
P.E.			
G.			
F.D.			

Loc. in Sec.
NW SW SW

Geol.

 Contr
Wentworth

Pool
Herres

FIRST REPORT
 MAR 7 '56

Date Comm.

Location

Co.

Use:

T

No.

56.

1.

५.

County	Barton	Elev.	1861
Sec.	33	Twp.	17
Company	Skelly Oil	Rge.	13W
Farm Name	O. A. French	No.	4

TOPS	DEPTH	LOG	DATUM	Loc. in Sec.
Anb.	791			NW SW SW
Tr.				
H.	3025			
Tr.	3041			
Dg.	3054			
BL.	3108		1247	
L.	3122		1261	
K.C.				Geol.
B.K.C.				Contr.
Ce.				Wentworth
C.				
M.				Pool
M.				Herres
K.				
Mz.				
Mo.				
V.				
S.				
S.				
A.	3336		1475	COMPLETE
R.				
Pe.				
G.				
T.D.	3337			

Date Comm. 3-16-56 MAY 2 1956

8 5/8" @ 799/450 5 1/2" @ 3336/125

DD 3345 B/ 12 goph 1 1/2 hr. 250 A

750 A S/ 23 bo 3 bw 10 hr. DD 3349

S/ 9 bo 2 bw 4 hr. DD 3353

S/ 9 bo 4 bw 6 hr. 1250 A

P/ 40 bo 24 hr. Comp. 85 bopd

O. W. D. D

FORM 513 SUNRAY

OWDD

County Barton Elev. 1854
 Sec. 33 Twp. 17 Rge. 13W
 Company Skelly Oil
 FarmName Herres SWD No. 3

Co.

Lse.

Sec.

T.

R.

TOPS	DEPTH	LOG	DATUM
Anh.			
Tr.			
H.			
Tr.			
Dg.			
BL.			
L.			
K.C.			
B.K.C.			
Ce.			
C.			
M.			
M.			
K.			
Mz.			
Me.			
V.			
S.			
S.			
A.			
R.			
PE.			
G.			
T.D.			

Loc. in Sec. NW SW SW

Geol. _____

Contr. _____

Pool Herres

FIRST REPORT
 MAY 29 59
 ABANDONED

Date Comm.

OTD 3373 5" @ 372 sq/ 3330-36

DD 3638 GO 3638

Comp. SWD well 157 bw 42 min.

USE # 1 WCL

D. J.