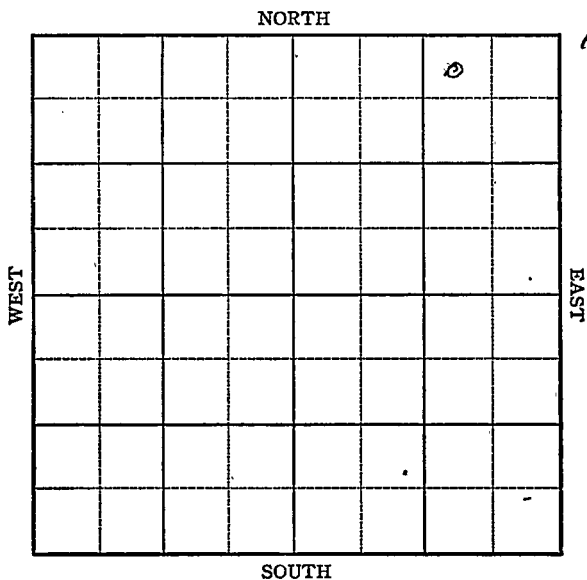


KANSAS

Barton county

Section 33 Township 17 Range 13-WWell No. #1, FennCompany Sunray Oil Company

HOT FILE

KANSAS

Barton County

Sec. 33 Twp. 17 R. 13W

Well No. #1 Fenn Farm

Sunray Oil Company

Wildcat

NORTH

3 30 Ft. from N. Line


Ft. from S. Line

990 Ft. from E. Line

Ft. from W. Line

NW NE NE

SOUTH

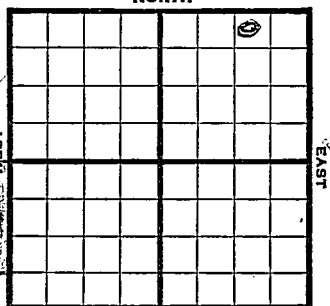

1946	Elev. 1921'	REPORT
9/11	RUR	
9/24	Lans 3182'	
	Arb 3405	
	SO 3415	
	TD 3417'	
	5" @ 3410'	RUST
10/1	1500 acid	
	Swb 24 oil plus 16 W in 7 hrs	
10/8	Pump 31 oil plus SW 24 hrs	
10/15	"	"
10/22	"	"
10/29	"	"
11/6	"	"
11/12	"	"
11/27	Pump 8 oil plus 37 W in 8 hrs	
12/1	"	"
12/10	"	"
12/17	"	"
1947		
1/2	Arb 3405'	
	5" @ 3410'	
	TD 3417'	
	500 Acid	
	Pump 10 Oil plus W Pot	
	38 Grav.	

COMPLETED

Kansas Pool Name WildcatMap No. 73 Sec. 33 Twp. 17 R. 13WWell No. 1 FennSunray Oil


Company

FIRST REPORT

Contractor

NW NE NE

SECTION PLAT

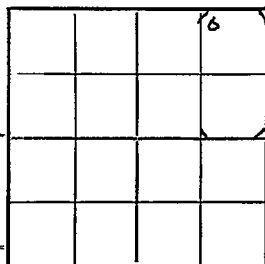330 Ft. from N. Line

Ft. from S. Line

990 Ft. from E. Line

Ft. from W. Line

Barton CountyN¹/₂-SE 32-17-13W

Location

Rig up

Drilling and Remarks:

R U R

RECORD

Cased _____ in., _____ ft.

Sand _____

Gas _____

Oil _____

Total Depth _____

PRODUCTION

1st 24 hrs. Nat. _____

1st 24 hrs. after shot _____

Gas _____ Cu. Ft.

Dry Hole _____

Abandoned _____

Date

9-11 1946S. J. LEWIS

Scout

Kansas

KANSAS

Map No. 73 Sec. 33 Twp. 17 R. 13WWell No. 1 Fenn

Sunray Oil

Company

COMPLETED

Contractor

NW NE NE

E 11/921

SECTION PLAT

330 Ft. from N. Line Ft. from S. Line990 Ft. from E. Line Ft. from W. Line

			0

Barton County

Location

Rig up

Drilling and Remarks:

*Ac 83405**5" @ 8410**5000 cu ft**Pump 10 oil + W**868**282 gr*

RECORD

Cased in., ft.Sand Gas Oil Total Depth 3412

PRODUCTION

1st 24 hrs. Nat. 1st 24 hrs. after shot Gas Cu. Ft.Dry Hole Abandoned

Date

JAN 2 1947

19

S. J. LEWIS

Scout