


Barton

KANSAS

SECTION 33 TOWNSHIP 17S RANGE 13W

WELL NO. #1 Finn

COMPANY Louis Mai

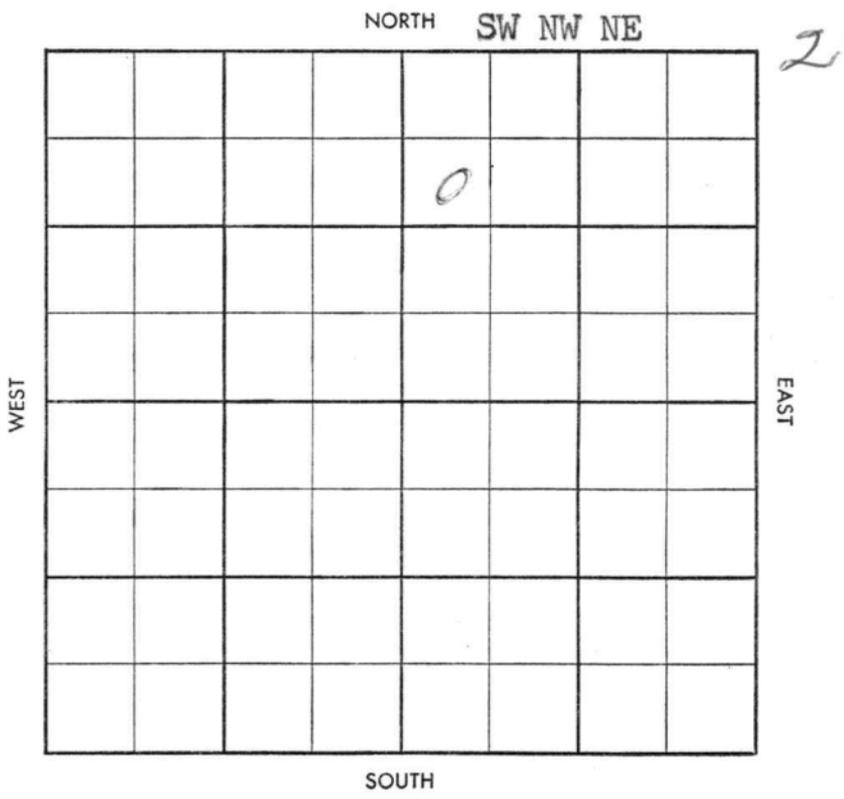



~~Twp. Pool~~

~~Co. Facet~~

S-513-B

County Barton Elev 1885 D.F. 1888 R.A.  
 Sec. 33 Twp. 17 Rge. 13W  
 Company Louis Mai  
 Farm Name Finn No. 1

TOPS	DEPTH	LOG	DATUM
Anh.	811		
Tp.			
H.	3062		
Tr.			
Dg.			
B.L.			
L.			
K.C.	3161		
B.K.C.			
Ce.			
C.			
M.			
M.			
K.			
Mz.			
Mq.			
V.			
S.			
S.			
A.	3383		
R.			
Pf.			
G.			
T.D.	3410		

Loc. in Sec. SW NW NE

Geol. \_\_\_\_\_  
Contr. \_\_\_\_\_  
East Drlg.

Pool Klug West

	0	

AUG 20 '58  
**ABANDONED**

Date Comm. 8-4-58 9" 350 450  
 Drlg. 250 AUG 13 '58 3328 AUG 20 '58

Nolay

D6A

Co.

Lse.

Z

Sec.

T.

R.