KANSAS


Form 51—5M—7-40—Palace

Russell

Section 30 Township 13- Range 12-W

Well No. #1 Shaffer

Company Seely & Shaffer

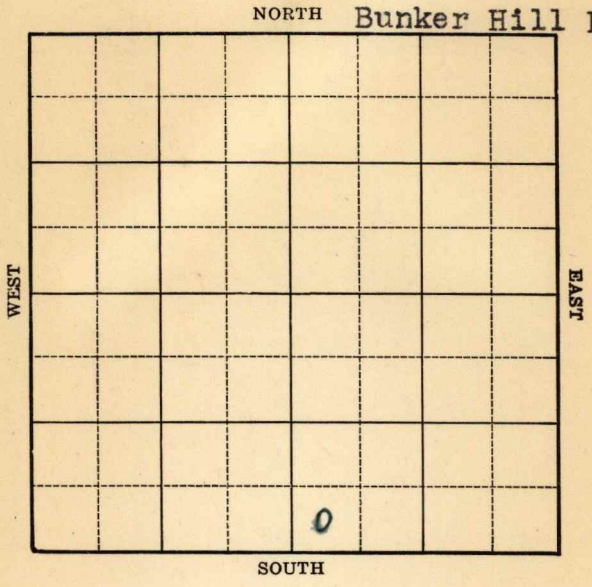

FORM 252-A 5M 1-41 PETROL KANSAS Russell

Sec. 30 Twp. 13 R. 12-W

Well No. #1 Shaffer Farm

Seely & Shaffer Company


(Bunker Hill)

____ Ft. from N. Line

330 Ft. from S. Line

____ Ft. from E. Line

330 Ft. from W. Line

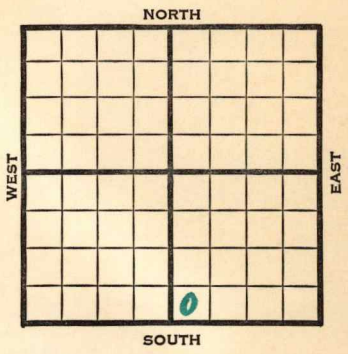

Elev. 1832

1941	REPORT
3/26	Location
4/2	12½" - 470' 10" - 764'
	Anhy 772' Drlg. 2415'
4/10	8" - 2560' Topeka 2811'?
	Drlg. 2860'
4/18	Lans. 2889 6" - 2993'
	Drlg. 3225'
4/24	Gorham 3300'? 5" - 3326'
	Drlg. 3332'
4/30	Arb. 3353'
	T.D. 3360'
	Water.
	ABANDONED

Form 26—200 Bks.—1-40—Palace Russell KANSAS

Map No. 56 Sec. 30 Twp. 13 R. 12W

Well No. 1 Shaffer

Seely & Shaffer Company

FIRST REPORT Contractor

SW SE

_____ Ft. from N. Line


330 Ft. from S. Line

_____ Ft. from E. Line

330 Ft. from W. Line

BUNKER HILL POOL

SECTION PLAT

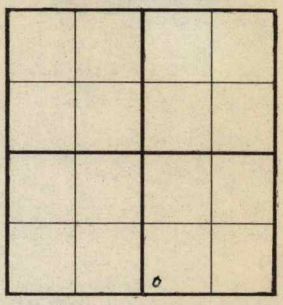

Location X

Rig up

Drilling and Remarks:

RECORD

Cased _____ in., _____ ft.

Sand

Gas

Oil

Total Depth

PRODUCTION

1st 24 hrs. Nat.

1st 24 hrs. after shot

Gas _____ Cu. Ft.

Dry Hole

Abandoned

Date

MAR 26 1941 19

S. J. LEWIS Scout

Form 26—200 Bks.—1-40—Palace Russell KANSAS

Map No. 56 Sec. 30 Twp. 13 R. 12W

Well No. 1 Shaffer

Seely & Shaffer Company

Contractor

ABANDONED

SW SE

Ft. from N. Line


330 Ft. from S. Line

Ft. from E. Line

330 Ft. from W. Line

BUNKER HILL POOL

SECTION PLAT

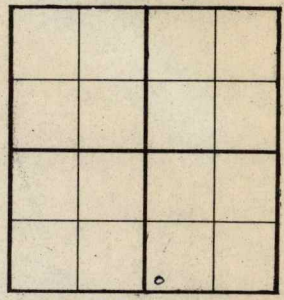

Location

Rig up

Drilling and Remarks:

Cir 3353

Water.

RECORD

Cased in., ft.

Sand

Gas

Oil

Total Depth 3360

PRODUCTION

1st 24 hrs. Nat.

1st 24 hrs. after shot

Gas Cu. Ft.

Dry Hole

Abandoned

Date

APR 30 1941 19

S. J. LEWIS Scout