


Map No. **KANSAS** Sec. *30* Twp. *13* R. *12 W*
Well No. *1-Shaffer* Farm
Roch & Gaurot Company

Russell

NORTH

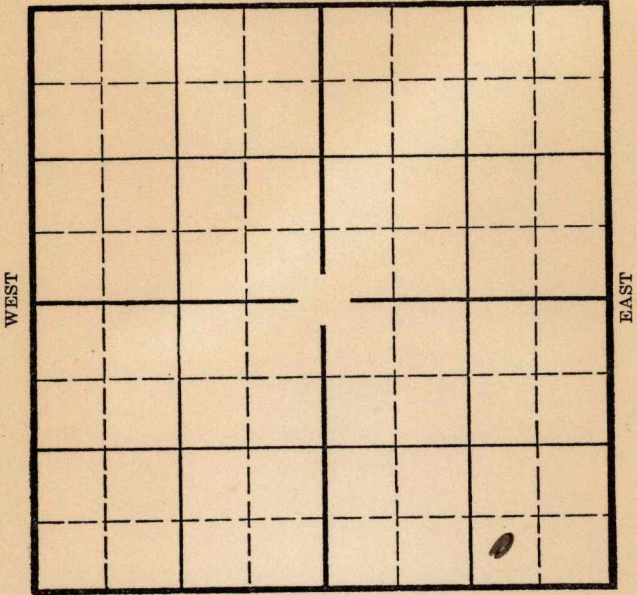

SOUTH

Location _____
Drilling Remarks _____

Rig Up _____
Drilling Remarks _____

RECORD

PRODUCTION

Cased _____ in. _____ ft.
Sand _____
Gas _____
Oil _____
Total Depth _____


1st 24 hrs. Nat. _____
1st 24 hrs. after shot _____
Gas _____ cu. ft. _____
Dry Hole _____
Abandoned _____

Russell

Map No. _____ Sec. 30 Twp. 13 R. 12^W
 Well No. 1-Shaffer Farm _____
Roth & Faurot Company _____

KANSAS

_____ Ft. from N. Line
330 Ft. from S. Line
990 Ft. from E. Line
 _____ Ft. from W. Line

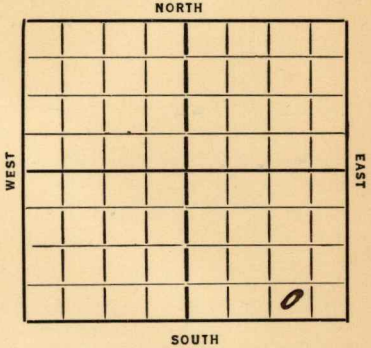

Elev. 1832

Date	REPORT
12/25	Pounds Mt
12/13	Ru
12/19	SD
2/26	1/2/36-
1/19	dlg 410 15" 320
1/17	TD 490 log
1/24	dlg 510 12" 478
1/31	" 1230 Ruby 765 10" 775
2/7	" 1995
2/14	" 2200 8" 2155
2/21	sg 2345-47
	dlg 2410
2/28	TD 2440 SD
3/6	8" 2405
3/13	8" 2423 TD 2525 UR 8"
3/20	--
3/27	T. Oswego 2971 Sm. Show oil 2990' HFW 3063 Drlg. 3090'
4/2	6"- 2973' T.D. 2995' U.R. 6".
4/10	6" @ 3195'
4/16	5" @ 3195' show oil 3208' Drlg 3210'

(OVER)

4/30-HFW 3352-61'. S.D.
5/7-Sil. 3350'. S.O. 3354-57'. U.R. 5".
5/14- 5" @ 3348'. T.D. 3359'.
5/21-HFW. Plug back.
5/28-- 6/4-- 6/11--~~6/18~~
6/18-P.B. to 3230'-1½ B.O. & 2 B.W.
6/25-Shut down.
7/2--
7/9-5000 gallons of acid. No test.
7/16-5000 gallons of acid. and 4000
gallons of acid. No test.
7/23-Pump 10 bbls of oil and 50 bbls of
water a day.
7/30-Testing.
8/5/36-Sil. 3350'.
T.D. 3359'.
Hole full of water.
P.B. to Gorham 3215-30'.
5000 gallons of acid.
Pump 12 bbls of oil and 7 bbls
of water.

COMPLETED

Map No. 57 Sec. 30 Twp. 13 R. 12W

Well No. 1-Shaffer

Roth + Maurer Company

Contractor

FIRST REPORTS

SECTION PLAT

.....Ft. from N. Line

330 Ft. from S. Line

990 Ft. from E. Line

.....Ft. from W. Line

			0

Location.....

Rig up.....

Drilling and Remarks:

Roads + Mat.

RECORD

Cased..... in.,ft.

Sand.....

Gas.....

Oil.....

Total Depth.....

PRODUCTION

1st 24 hrs. Nat.....

1st 24 hrs. after shot.....

Gas..... Cu. Ft.

Dry Hole.....

Abandoned.....

Date

12-4-35 192.....

Scout

ORVAL MANNSCHECK

Map No. 52 Sec. 30 Twp. 13 R. 12W

Well No. 1 Shaffer

Roth & Fawcett Company

Contractor

SECTION PLAT

_____ Ft. from N. Line

320 Ft. from S. Line

990 Ft. from E. Line

_____ Ft. from W. Line

			0

COMPLETED

Location _____

Rig up _____

Drilling and Remarks:

Oil 3350
NFW
P.B. Gokham
3215-30
5000 acid
Pump 12 oil
7 Water.

RECORD

Cased _____ in., _____ ft.

Sand _____

Gas _____

Oil _____

Total Depth 3359

PRODUCTION

1st 24 hrs. Nat. _____

1st 24 hrs. after shot _____

Gas _____ Cu. Ft.

Dry Hole _____

Abandoned _____

Date

AUG 5 1936 19

S. J. LEWIS Scout