


Russell

KANSAS

Section 31 Township 13 Range 12-W

Well No. 4 Lulu Gross


Company R. H. Shields et al

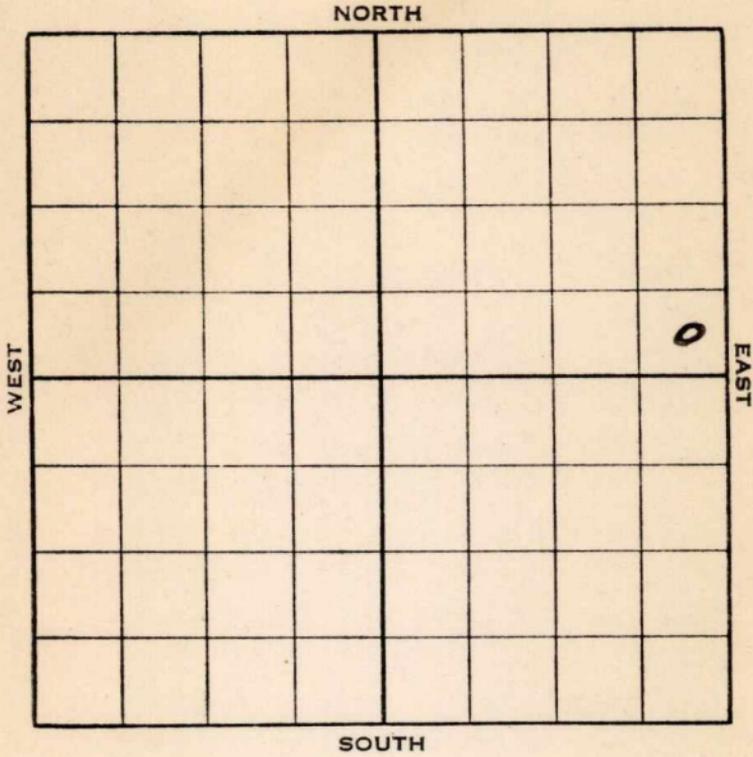

Sec. 31 Twp. 13 R. 12-W

Well No. #4 Lulu Gross Farm
R. H. Shields et al Company

_____ Ft. from N. Line
330 Ft. from S. Line
330 Ft. from E. Line
 _____ Ft. from W. Line

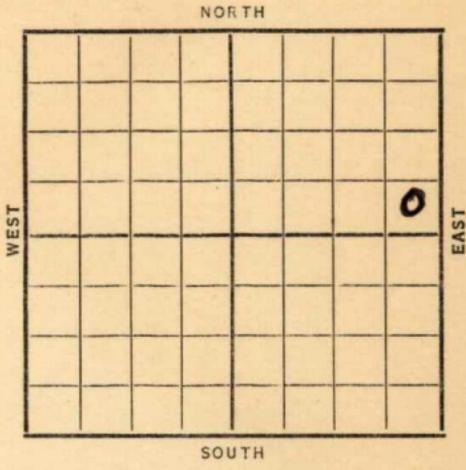

Elev. 1828

Date	REPORT
1938	
7/13	RUC.
7/22	"
7/29	12" - 404'. Anhy 740'.
	10" - 754'. Dlg. 1475'.
8/5	T.D. 2060'. Cleaning out.
8/12	S.G. 2075-80'. Topeka 2630'.
	8" - 2647'. Dlg. 2800'.
8/19	7" - 2835'. Lans. 2976'.
	5" - 3034'. H. F. W. 3062-70'.
	S. D. O.
8/26	Will perf. csg. 2993-98'.
9/2	20 qts. 2994-97'.
	6 bailer wtr. & 3 bailer oil in
	24 hrs.
9/9	500 acid. No test.
9/16	Pumped 3 oil & 20 water daily.
	Shut down orders.
9/23	" " "
9/30	" " "

OVER

1938

10/5

5" - 3034'.

Lans. 2976'.

T. D. 3070'.

Perf. 2994-97 with 20 shots.

Potential 263 bbls.

15% water.

COMPLETED

Map No. 56 Sec. 31 Twp. 13 R. 12W

Well No. 4 Lulu Gross

R. H. Shields etal

Company

(formerly belonged to Equity Gas) Contractor

FIRST REPORT

SECTION PLAT

SE NE

_____ Ft. from N. Line

330 Ft. from S. Line

330 Ft. from E. Line

_____ Ft. from W. Line

Location _____

Rig up _____

Drilling and Remarks:

RUC

RECORD

Cased _____ in., _____ ft.

Sand _____

Gas _____

Oil _____

Total Depth _____

PRODUCTION

1st 24 hrs. Nat. _____

1st 24 hrs. after shot _____

Gas _____ Cu. Ft.

Dry Hole _____

Abandoned _____

Date

JUL 13 1938 19 H. D. Hatfield Scout

