

KANSAS

Barton

Section 34 Township 17S Range 13WWell No. #1 RichetteCompany Bay Pet. Corp.

NORTH

7

				0			

SOUTH

1

WEST

EAST

KANSAS Barton

Sec. 34 Twp. 17 R. 13-W

Well No. #1 Richette Farm

Bay Pet. etal Company

McCauley


Ft. from N. Line

330 Ft. from S. Line

Ft. from E. Line

330 Ft. from W. Line

SW NE

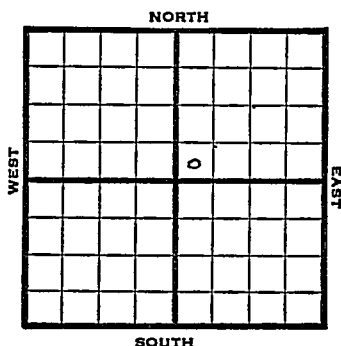

1949 ¹⁵lev 1890' REPORT

10/4 8" @ 546
Anhy 798
Drlg 980
10/12 Lansing 3151'
Drlg 3283'
10/19 Arbuckle 3391'
TD 3414'
5 @ 3326'
10/26 36 shots 3284-90 - 500 acid
Swb 9 bbls oil FH, 8 hrs
11/1 "
11/9 "
11/16 TD 3414'
Arb. 3391'
5" @ 3326'
Lansing 3151'
Perf Lans
500 acid
Pump 78 Oil Pot
37° Gr.
Comp

COMPLETED

Map No. _____ Sec. 34 Twp. 17 R. 13W

Well No. 1 Richette

Bay Pet. etal. _____ Company _____

Ash _____ Contractor _____

SW NE


**FIRST REPORT
SECTION PLAT**

_____ Ft. from N. Line

330 _____ Ft. from S. Line

_____ Ft. from E. Line

330 _____ Ft. from W. Line

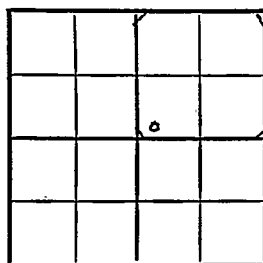

Barton County

Location _____

Rig up _____

Drilling and Remarks:

8" @ 546

Anhy 798

drlg. 980

RECORD

Cased _____ in., _____ ft.

Sand _____

Gas _____

Oil _____

Total Depth _____

PRODUCTION

1st 24 hrs. Nat. _____

1st 24 hrs. after shot _____

Gas _____ Cu. Ft.

Dry Hole _____

Abandoned _____

Date

OCT 5 1949 19

S. J. LEWIS Scout

Kansas

Map No. _____ Sec. 34 Twp. 17 R. 13WWell No. 1 Richetti

Bay Pet. etal. _____ Company _____

COMPLETE

Contractor _____

SW NE

E. 1890
SECTION PLAT


_____ Ft. from N. Line

330 Ft. from S. Line

_____ Ft. from E. Line

330 Ft. from W. Line

Barton County

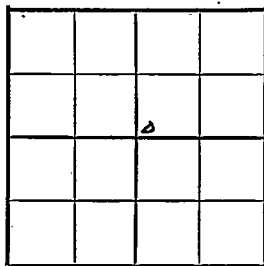

Location _____

Rig up _____

Drilling and Remarks:

Cor 33515" 02226Lone 3151Prof LoneGood acidOmge 77 oil 1st
870 lb

RECORD

Cased _____ in., _____ ft.

Sand _____

Gas _____

Oil _____

Total Depth 13414

PRODUCTION

1st 24 hrs. Nat. _____

1st 24 hrs. after shot _____

Gas _____ Cu. Ft.

Dry Hole _____

Abandoned _____

Date

NOV 16 1949 19

S. J. LEWIS Scout