


KANSAS

Barton

Section 34 Township 17S Range 13W

Well No. #1 Sausen

Company Bay Pet. & Assoc.

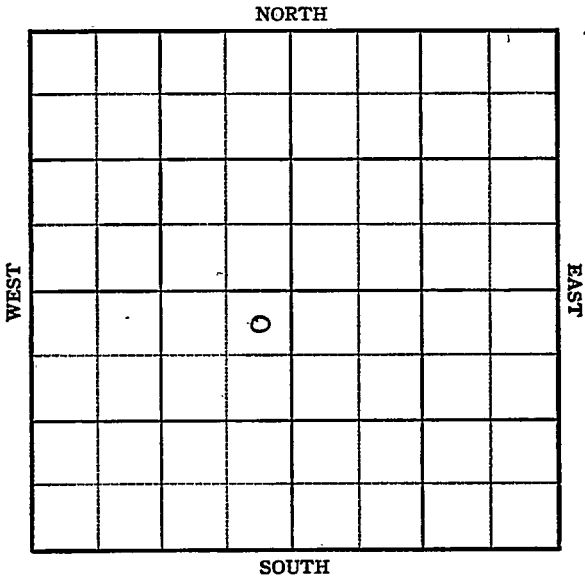

Sec. 34 Twp. 17 R. 13W ✓

Well No. #1 Sausen Farm

Bay Pet. & Ash

Company

McCullough Pool (C.E. Ash, Cont.)


330' Ft. from N. Line

_____ Ft. from S. Line

330' Ft. from E. Line

_____ Ft. from W. Line

NE SW

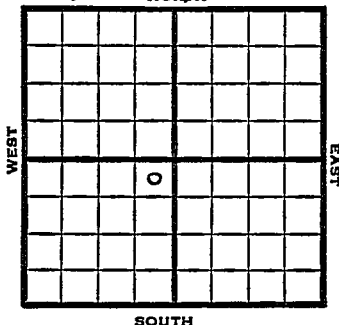

1949

Elef 1891' REPORT

9/14

Location

9/21

8" @ 540'

Drlg. 580'

9/28

Lansing 3151

Drlg 3187'

10/5

Arb. 3479'

TD 3487'

5" @ 3480

500 acid

10/12

"

10/19

TD 3405'

PB 3310

24 shots 3280-84'

500 acid

Swb 7 bbls oil PH

10/26

"

11/1

"

11/9

"

11/16

TD 3405'

Lansing 3151'

Arb. 3379'

5" @ 3380'

Perf Lans

500 acid

Pump 181 Oil Pot

36° Gr.

Comp

COMPLETED

Map No. _____ Sec. 34 Twp. 17 R. 13W

Well No. 1 Sausen

Bay Pet. & Ash Company

C. E. Ash Contractor

NE SW

SECTION PLAT

330 Ft. from N. Line

_____ Ft. from S. Line

330 Ft. from E. Line

_____ Ft. from W. Line

Barton County

Location X

Rig up _____

Drilling and Remarks:

RECORD

Cased _____ in., _____ ft.

Sand _____

Gas _____

Oil _____

Total Depth _____

PRODUCTION

1st 24 hrs. Nat. _____

1st 24 hrs. after shot _____

Gas _____ Cu. Ft.

Dry Hole _____

Abandoned _____

Date

SEP. 14 1949 19

S. L. LEWIS Scout

Map No. _____ Sec. 34 Twp. 17 R. 13W

Well No. 1 Sausen

Bay Pet. & Ash Company

COMPLETE

Contractor

NE SW

E. 1891
SECTION PLAT

330 Ft. from N. Line

_____ Ft. from S. Line

330 Ft. from E. Line

_____ Ft. from W. Line

	6		

Barton County

Location _____

Rig up _____

Drilling and Remarks:

Lane 3151
CRX 3379
5" C 3380
Perf. Lam.
Foocand
Pump Soil Dr.
36 1/2 ft

RECORD

Cased _____ in., _____ ft.

Sand _____

Gas _____

Oil _____

Total Depth 3405

PRODUCTION

1st 24 hrs. Nat. _____

1st 24 hrs. after shot _____

Gas _____ Cu. Ft.

Dry Hole _____

Abandoned _____

Date

NOV 16 1949 19

S. J. LEWIS Scout