

Russell

Map No. **KANSAS** Sec. 31 Twp. 13 R. 12^w

Well No. 1 - Shaffer Farm
Roth & Faurot Company


660
~~330~~ Ft. from N. Line

_____ Ft. from S. Line

_____ Ft. from E. Line

660
~~330~~ Ft. from W. Line

Elev. **1839 US**
1834 UP

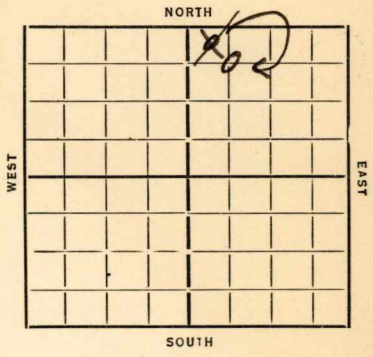

Date	REPORT
6/17	Pouls
6/20	—
6/28	Mch.
7/3	Spud & sh
7/11	dyg 414 15" 390
7/18	465 feg
8/8	dyg 2205
8/15	8" 2268 1 1/2 m Gas 2340 WR 8" 2412
8/22	—
8/29	2500 WR 8"
9/6	dyg 2670 8" 2621
10/3	—
10/10	1000 acid
10/24	Lansing 2965 TD 3002H PB 3000 274 Oil 70 Water

COMPLETED

Map No. 56 Sec. 31 Twp. 13 R. 12W

Well No. 1 - Shaffer

Roth + Maurat Company

Contractor

CORRECTION

SECTION PLAT

660 Ft. from N. Line

..... Ft. from S. Line

..... Ft. from E. Line

660 Ft. from W. Line

		0	

CORRECTION

RECORD

Location.....

Cased..... in., ft.

Rig up.....

Sand.....

Drilling and Remarks:

Gas.....

Oil.....

Total Depth.....

*Formerly reported
in NW NE*

PRODUCTION

1st 24 hrs. Nat.....

1st 24 hrs. after shot.....

Gas..... Cu. Ft.

Dry Hole.....

Abandoned.....

Date

7-10-35 192

ORVAL MANNSCHECK Scout

Map No. 57 Sec. 31 Twp. 13 R. 12^w

Well No. 1-Shaffer

Roth & Maurer Company

Contractor

COMPLETED

SECTION PLAT

		0	

660 Ft. from N. Line

..... Ft. from S. Line

..... Ft. from E. Line

660 Ft. from W. Line

Location.....

Rig up.....

Drilling and Remarks:

PB 3000

274 oil
70 water

RECORD

Cased..... in., ft.

Sand January 29 1965

Gas.....

Oil.....

Total Depth 3007

PRODUCTION

1st 24 hrs. Nat.....

1st 24 hrs. after shot.....

Gas..... Cu. Ft.

Dry Hole.....

Abandoned.....

Date

10-24-35 192

ORVAL MANNSCHECK

Scout

Map No. 56 Sec. 31 Twp. 13 R. 12

Well No. 1-Shaffer

Rath + Maurer Company

Contractor

FIRST REPORTS

SECTION PLAT

330 Ft. from N. Line

..... Ft. from S. Line

..... Ft. from E. Line

330 Ft. from W. Line

		0	

Location.....

Rig up.....

Drilling and Remarks:

Ponds

RECORD

Cased..... in., ft.

Sand.....

Gas.....

Oil.....

Total Depth.....

PRODUCTION

1st 24 hrs. Nat.....

1st 24 hrs. after shot.....

Gas..... Cu. Ft.

Dry Hole.....

Abandoned.....

Date

6-12-35

192

ORVAL MANNSCHECK

Scout