


Russell

Form 51-5M-5-34-Palace

Map No. **KANSAS** Sec. 34 Twp. 13 R. 12 W

Well No. 1 Moore Farm
Lario & Barbour & Corbett Company

NORTH

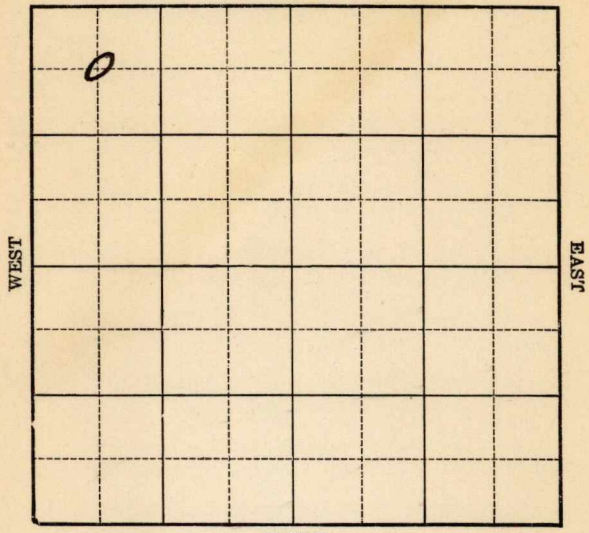

SOUTH

Location _____

Drilling Remarks _____

Rig Up _____

Drilling Remarks _____

RECORD

Cased _____ in. _____ ft.

Sand _____

Gas _____

Oil _____

Total Depth _____

PRODUCTION

1st 24 hrs. Nat. _____

1st 24 hrs. after shot _____

Gas _____ cu. ft.

Dry Hole _____

Abandoned _____

Russell

Map No. KANSAS Sec. 34 Twp. 13 R. 12 W


Well No. 1 Moore Farm
Lario & Barbour & Corbett Company

760 Ft. from N. Line

_____ Ft. from S. Line

_____ Ft. from E. Line

660 Ft. from W. Line

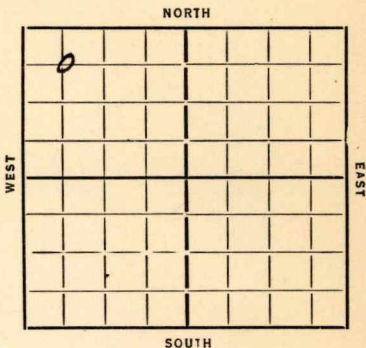

Date

REPORT

1/28/34		
11/7	Location	
11/15	—	11/22 — 11/28 — 12/6 —
12/15	—	12/21 —
12/27	Bldg Rig	
1/3/35	Rgn up	
1/10		
1/17	57 530	
1/24	dy 1245	15 1/2 528
1/31	" 2115	
2/7	" 2425	10" 2408
2/14	" 3005	
2/21	HFW 3080 8" 3120	T 1) 3320
	Run 6" Lansing	2975
2/27	Silicious 3422	T 1) 3425
		17 & A.

ABANDONED

Map No. 56 Sec. 34 Twp. 13 R. 12W

Well No. 1-Moore
Lario + Barbours + Corbett Company

Contractor

FIRST REPORTS SECTION PLAT

760 Ft. from N. Line

..... Ft. from S. Line

..... Ft. from E. Line

660 Ft. from W. Line

0			

Location

Rig up

Drilling and Remarks:

RECORD

Cased in., ft.

Sand

Gas

Oil

Total Depth

PRODUCTION

1st 24 hrs. Nat.

1st 24 hrs. after shot

Gas Cu. Ft.

Dry Hole

Abandoned

Date

11-7-37 192 ORVAL MANNSCHRECK Scout

Map No. 56 Sec. 34 Twp. 13 R. 12W

Well No. 1-Moore

Lario + Barbons-Corbitt Company

Contractor

COMPLETED

SECTION PLAT

760 Ft. from N. Line
..... Ft. from S. Line
..... Ft. from E. Line
660 Ft. from W. Line

0			

Location.....
Rig up.....
Drilling and Remarks:

N + A

RECORD

Cased..... in., ft.
Sand silicious 3422
Gas.....
Oil.....
Total Depth 3425

PRODUCTION

1st 24 hrs. Nat.....
1st 24 hrs. after shot.....
Gas..... Cu. Ft.
Dry Hole.....
Abandoned.....

Date

2-27-35 192.....

ORVAL MANNSCHRECK

Scout