


Section 35 ⁷⁴ ₂₀₁₂ Township 17 Range 13W

Well No. #1 Moses Est. "C"

Company C. E. Ash

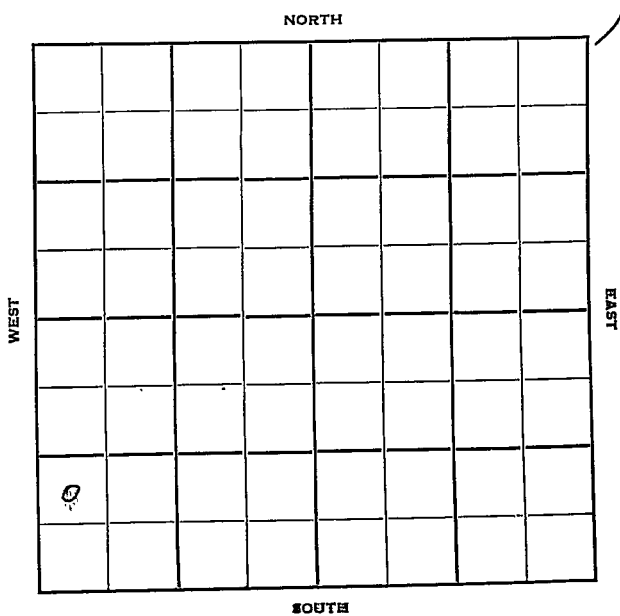

Sec. 35 Twp. 17 R. 13-W

Well No. #1 Moses Est. "C" Farm

C E Ash Company

Contractor


Ft. from N. Line

990 Ft. from S. Line

Ft. from E. Line

330 Ft. from W. Line

NW SW SW

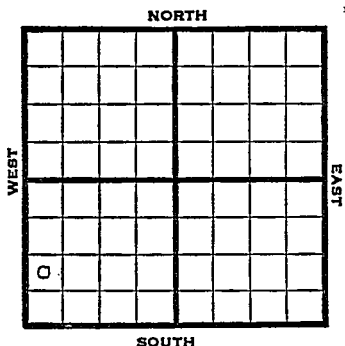

1950 Elev 1820 REPORT

7/26 Rig Up

8/16 Anhy 705-40

8" @ 722

Br line 3083

Lans 3097

Arb 3328

TD 3363

D&A

ABANDONED

Map No. _____ Sec. 35 Twp. 17 R. 13W

Well No. 1 Moses Est. "C"

C. E. Ash Company

Contractor

NW SW SW

_____ Ft. from N. Line

990 Ft. from S. Line

_____ Ft. from E. Line

330 Ft. from W. Line

SECTION PLAT

o			

FIRST REPORT

Barton County

Location _____

Rig up X

Drilling and Remarks:

RECORD

Cased _____ in., _____ ft.

Sand _____

Gas _____

Oil _____

Total Depth _____

PRODUCTION

1st 24 hrs. Nat. _____

1st 24 hrs. after shot _____

Gas _____ Cu. Ft.

Dry Hole _____

Abandoned _____

Date

JUL 26 1950 19

J. E. TYRA Scout

