


Section 31 Township 13 Range 12W

Well No. #1 Gross

Company Stearns Drlg.

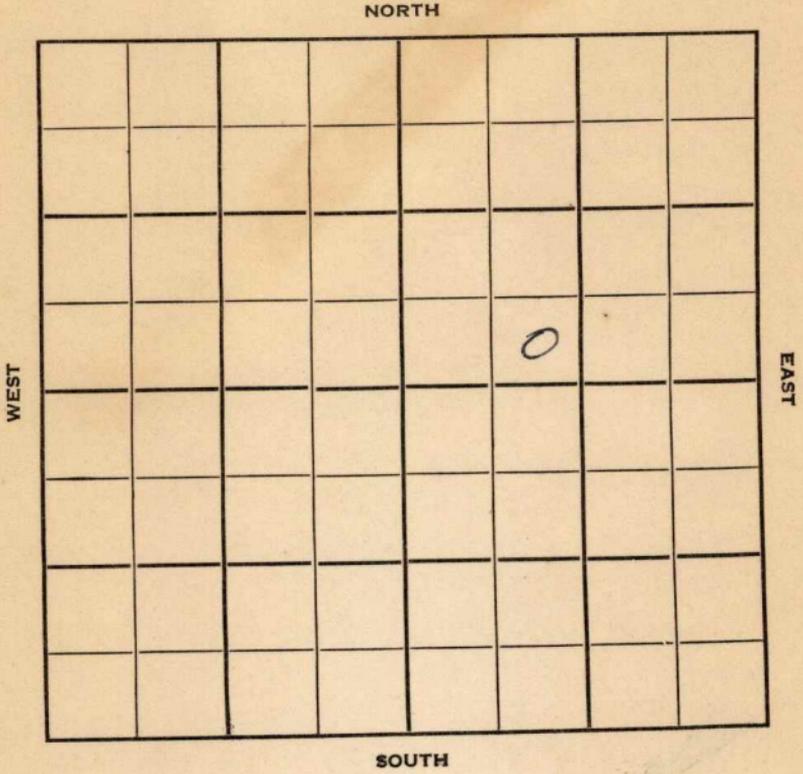

Sec. 31 Twp. 13 R. 12W ✓

Well No. #1 Gross Farm

Stearns Drlg. Company

Contractor

Bunker Hill Pool


Ft. from N. Line

330' Ft. from S. Line

Ft. from E. Line

990' Ft. from W. Line

SE SW NE

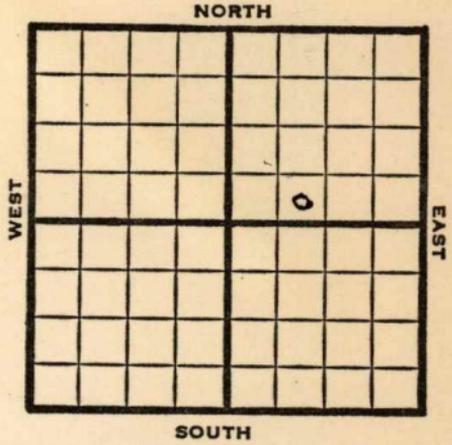

1950

Elev. 1845' REPORT

1/25 RUR

4/19 TD 3354'

13"@ 486'

10"@ 769'

Dodge 2960'

KC 2998'

7"@ 2961'

Cong 3337'

D&A

Aband.

ABANDONED

Kansas

Map No. _____ Sec. 31 Twp. 13 R. 12W

Well No. 1 Gross


_____ Stearns Drlg. _____ Company

_____ Contractor

SE SW NE

E. 1845

SECTION PLAT

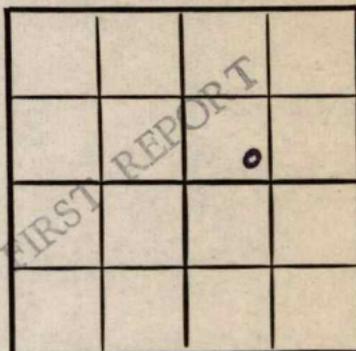

_____ Ft. from N. Line

330 Ft. from S. Line

_____ Ft. from E. Line

990 Ft. from W. Line

Russell County

Location _____

Rig up _____

Drilling and Remarks:

R U R

RECORD

Cased _____ in., _____ ft.

Sand _____

Gas _____

Oil _____

Total Depth _____

PRODUCTION

1st 24 hrs. Nat. _____

1st 24 hrs. after shot _____

Gas _____ Cu. Ft.

Dry Hole _____

Abandoned _____

Date

JAN 25 1950

19

J. E. TYRA

Scout

Map No. _____ Sec. 31 Twp. 13 R. 12W

Well No. 1 Gross

Stearns Drlg. Company

Contractor

SE SW NE


E. 1845
SECTION PLAT

_____ Ft. from N. Line

330 Ft. from S. Line

_____ Ft. from E. Line

990 Ft. from W. Line

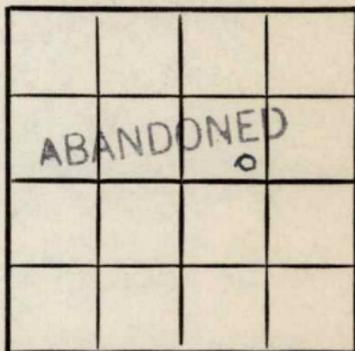

Russell County

Location _____

Rig up _____

Drilling and Remarks:

13" @ 486
10" @ 769
Dozde 2960
K.C. 2998
7" @ 2961
Comp 3337
OTA

RECORD

Cased _____ in., _____ ft.

Sand _____

Gas _____

Oil _____

Total Depth 3354

PRODUCTION

1st 24 hrs. Nat. _____

1st 24 hrs. after shot _____

Gas _____ Cu. Ft.

Dry Hole _____

Abandoned _____

Date

APR 19 1950 19

J. E. TYRA

Scout