

KANSAS

Barton

Section 34 Township 17 Range 13W

Well No. 1 McCauley

Company Bay Pet et al

Hoisington Pool

NORTH

				o			

10

WEST

EAST

SOUTH

Sec. 34 Twp. 17 R. 13W

Well No. #1 McCauley Farm

Bay Pet. et al Company


Hoisington Pool

330' Ft. from N. Line

_____ Ft. from S. Line

_____ Ft. from E. Line

330' Ft. from W. Line

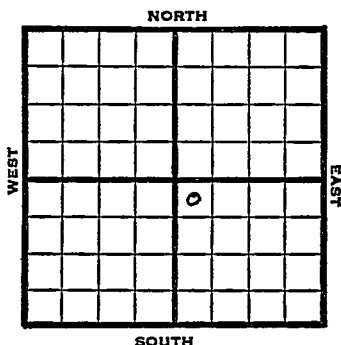

NW SE

1949 Elev 1888' REPORT

8/3 S H

8/10 8"@ 548'
Drlg 2968'

8/17 Lansing 3146'
Arb. 3377-79'
TD 3379'
5"@ 3378'

8/24 TD 3408-500 acid w/PB

8/31 PB 3110'
24 shots 3276 - 500 acid
1000 acid swb 6 bbls oil PH

9/7 "

9/14 TD 3408'
Lans. 3146'
A rb. 3377'
5"@ 3378'
5"@ 3378'
Perf Lans 1500 acid
Pump 121 oil / 22% W Pot
36° Gr1
Comp

COMPLETED

Kansas

Hoisington Pool

Map No. _____ Sec. 34 Twp. 17 R. 13W

Well No. 1 McCauley

Bay Pet et al. _____ Company

C. Eash _____ Contractor

NW SE

FIRST REPORT
SECTION PLAT

330 Ft. from N. Line

_____ Ft. from S. Line

_____ Ft. from E. Line

330 Ft. from W. Line

		o	

Barton County

Location _____

Rig up _____

Drilling and Remarks:

S H

RECORD

Cased _____ in., _____ ft.

Sand _____

Gas _____

Oil _____

Total Depth _____

PRODUCTION

1st 24 hrs. Nat. _____

1st 24 hrs. after shot _____

Gas _____ Cu. Ft.

Dry Hole _____

Abandoned _____

Date

AUG 3

1949

19

S. J. LEWIS

Scout

Kansas

Map No. K73 Sec. 34 Twp. 17 R. 13WWell No. 1 McCauleyBay Pet. etal.

Company

COMPLETE


Contractor

NW SE

E. 1888
SECTION PLAT330 Ft. from N. Line

_____ Ft. from S. Line

_____ Ft. from E. Line

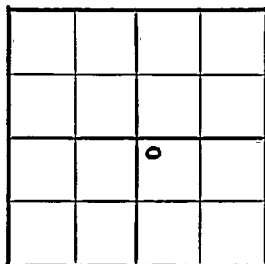330 Ft. from W. Line

Barton County

Location _____

Rig up _____

Drilling and Remarks:

Loc. 3146Cr 33975" 6337Perf. base1500 cu ftPump 12100 ft22 1/2 W Rd

RECORD

Cased _____ in., _____ ft.

Sand _____

Gas _____

Oil _____

Total Depth 3408

PRODUCTION

1st 24 hrs. Nat. _____

1st 24 hrs. after shot _____

Gas _____ Cu. Ft.

Dry Hole _____

Abandoned _____

Date

06th Apr.

SEP 14 1949

19

S. J. LEWIS Scout