

Barton

KANSAS

Section 1 Township 17 Range 14WWell No. #1 PutmanCompany Picknell Drlg.

NORTH

WEST

EAST

0							

SOUTH

13

Barton

KANSAS

Sec. 1 Twp. 17 R. 14W

Well No. #1 Putman Farm

Picknell Drlg. Company

Semi-Wildcat Contractor

Ft. from N. Line

330


Ft. from S. Line

Ft. from E. Line

330

Ft. from W. Line

SW SW SW

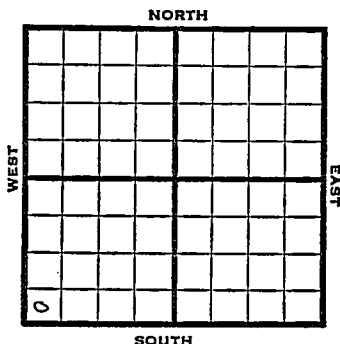

1951

Elev. 1984' REPORT

10/31

Spud 10-28-51

Anhy. 945

Drlg. 1950'

12/5

Spud 10-28-51

Oil Well Td 3530'

Anhy 945 Top. 2906

Heeb. 3141 Boug. 3170

Br. Li 3215 Ians. 3224

DST 3218-58 open 53 min.

Rec. 30' OCM 60' HOCM

200' mud & oil

DST 3272-97 open 1 hr. Rec. 120'

O&GCM 200' mud & oil

Cong. 3436 Arb. 3501

TD 3530 5" @ 3505

24/ 3288-94 1000 A S/ 1 1/2 BOPH

SP 3285 15/ 3279-84 9/ 3273-76

1000 A S/ 1 BOPH 2000 A

SP 3260 18/ 3249-55 5500 A

SP 3245 22/ 3225-33 1 BOPH

500 A S/ 100 BO 8 hr.

Comp. 287 BOPD

COMPLETED

County Barton State Kansas

Sec. 1 (Blk. 17) (Sur. 14) Map No. _____

Operator Picknell Drlg.

Well No. 1 Farm Putman

Elev.	Location	SW	SW	SW
-------	----------	----	----	----

FIRST REPORT

330 Ft. From S Line SW

330 Ft. From VI Line Quarter

1st. Report **OCT 31 1951**

Completion _____

Remarks _____

Spudding Date **10-28-51**

Drlg. Data Semi Wildcat

Anhy 945 Drlg. 1950

J. E. TYRA

County Barton State KansasSec. 1 (Blk. Twp.) 17 (Sur. Rge.) 14W Map No.Operator Pickrell Drlg.Well No. 1 Farm PutmanElev. 1984 Location SW SW SW

0							

330 Ft. From S Line SW330 Ft. From W Line Quarter

1st. Report

Completion DEC 5 1951Remarks Semi WilcoatSpudding Date 10-28-51Drlg. Data Oil well TD 3530Anhy 945 Top. 2906 Heeb. 3141Doug. 3170 Br. lime 3215 Lans. 3224DST 3218-58 open 53 min. Rec. 30' ocm60' hocm 200' mud & oil DST 3272-97open 1 hr. Rec. 120' o & gcm 200' mud& oil Cong. 3436 Arb. 3501 TD 35305" @3505 24/ 3288-94 1000 A S/ 1½ bophSP 3285 15/ 3279-84 9/ 3273-76 1000 AS/ 1 boph 2000 A SP 3260 18/ 3249-555500 A SP 3245 22/ 3225-33 1 boph500 A S/ 100 bo 8 hr.Comp. 287 bopd

J. E. TYRA