


# KANSAS Barton County

FORM 51 5M BRIX

Section 1 Township 17 Range 14W

Well No. #1 F. L. Putman

Company Stanolind

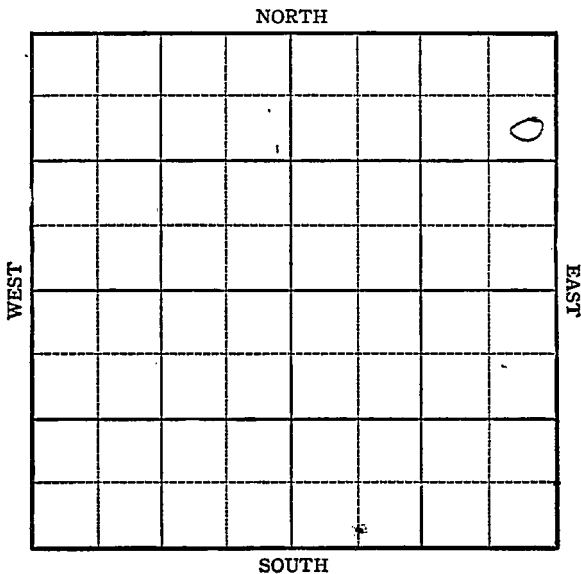

**KANSAS**

Barton County

Sec. 1 Twp. 17 R. 14W

Well No. #1 F. L. Putman Farm

Stanolind Company


Barrett

990 Ft. from N. Line

         Ft. from S. Line

330 Ft. from E. Line

         Ft. from W. Line

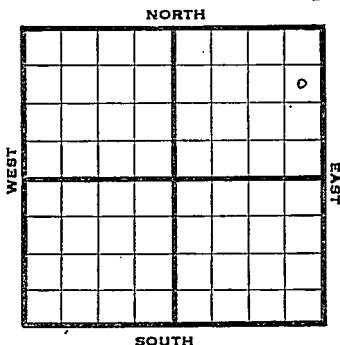

SE NE NE

1944

R E P O R T

10/11 13" - 299 WOG  
 10/18 Anhy 941 Drlg. 2400  
 10/25 Topeka 2900  
       Lans 3215  
       Cong. 3439  
       Drlg. 3465 in Gong.  
 11/1 Arb 3471  
       TD 3491  
       No shows

**ABANDONED**

KANSAS

Pool Name Barrett

Map No. 73 Sec. 1 Twp. 17 R. 14W

Well No. I F. L. Putman

Stanolind Company

FIRST REPORT Contractor

SE NE NE

SECTION PLAT

990 Ft. from N. Line

\_\_\_\_\_ Ft. from S. Line

330 Ft. from E. Line

\_\_\_\_\_ Ft. from W. Line

|  |  |  |   |
|--|--|--|---|
|  |  |  |   |
|  |  |  | 5 |
|  |  |  |   |
|  |  |  |   |

Barton County

RECORD

Location \_\_\_\_\_

Rig up \_\_\_\_\_

Drilling and Remarks:

13" -299 WOC

Cased \_\_\_\_\_ in., \_\_\_\_\_ ft.

Sand \_\_\_\_\_

Gas \_\_\_\_\_

Oil \_\_\_\_\_

Total Depth \_\_\_\_\_

PRODUCTION

1st 24 hrs. Nat. \_\_\_\_\_

1st 24 hrs. after shot \_\_\_\_\_

Gas \_\_\_\_\_ Cu. Ft.

Dry Hole \_\_\_\_\_

Abandoned \_\_\_\_\_

*Hot File*

Date

OCT 1 1 1944 19

S. J. LEWIS Scout

Pool Name BarrettMap No. 73 Sec. 1 Twp. 17 R. 14WWell No. 1 F. L. PutmanStanolind

Company

ABANDONED

Contractor

SE NE NE

## SECTION PLAT

990 Ft. from N. Line

Ft. from S. Line

330 Ft. from E. Line

Ft. from W. Line

|  |  |  |   |
|--|--|--|---|
|  |  |  |   |
|  |  |  | 0 |
|  |  |  |   |
|  |  |  |   |
|  |  |  |   |

Barton County

Location \_\_\_\_\_

Rig up \_\_\_\_\_

Drilling and Remarks:

*Per 3471**No show*

## RECORD

Cased \_\_\_\_\_ in., \_\_\_\_\_ ft.

Sand \_\_\_\_\_

Gas \_\_\_\_\_

Oil \_\_\_\_\_

Total Depth 3491

## PRODUCTION

1st 24 hrs. Nat. \_\_\_\_\_

1st 24 hrs. after shot \_\_\_\_\_

Gas \_\_\_\_\_ Cu. Ft.

Dry Hole \_\_\_\_\_

Abandoned \_\_\_\_\_

Date

NOV 1 1944 19S. J. LEWIS Scout