

KANSAS


Russell

FORM 51 25M 3-49 PETROL

Section 30 Township 13 Range 13-W

Well No. #1 Bell

Company Shields et al.  
Wildcat

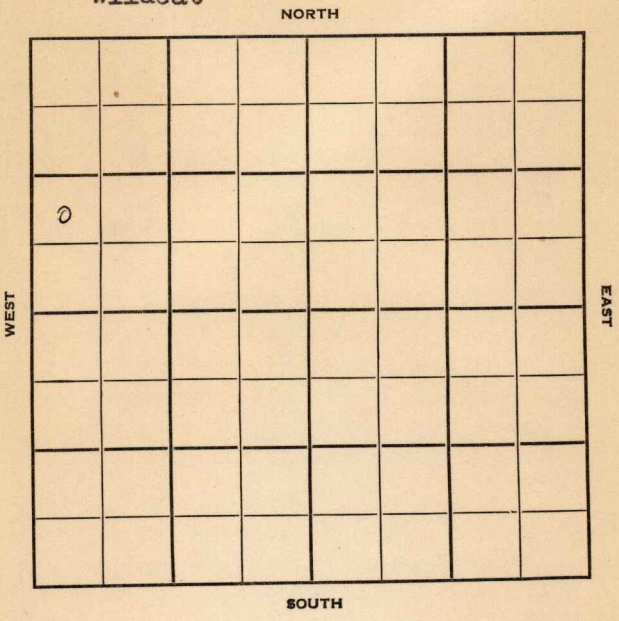

Russell

KANSAS

Sec. 30 Twp. 13 R. 13W ✓

Well No. #1 Bell Farm

Shields et al Company

Contractor

Wildcat


           Ft. from N. Line

990' Ft. from S. Line

           Ft. from E. Line

330' Ft. from W. Line

NW SW NW

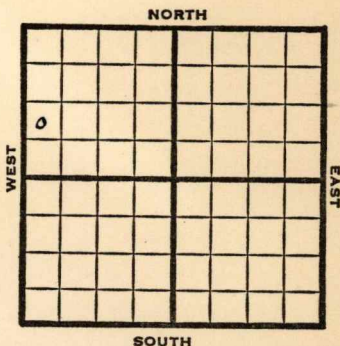

1950

Elev. 1857' REPORT

3/8

Location

4/19

TD 3880'  
 12"@ 467'  
 10"@ 865'  
 8"@ 2391  
 Tonkio 2387'  
 Topeka 2735'  
 Heeb 2964'  
 Douglas 3000'  
 Lans 3023'  
 Arb. 3375'  
 D&A  
 Aband.

**ABANDONED**

Kansas

Wildcat

Map No. \_\_\_\_\_ Sec. 30 Twp. 13 R. 13W

Well No. 1 Bell

Shields etal.

Company

Contractor

NW SW NW

E1. 1857  
SECTION PLAT

\_\_\_\_\_ Ft. from N. Line

990 Ft. from S. Line

\_\_\_\_\_ Ft. from E. Line

330 Ft. from W. Line

o			

FIRST REPORT

Russell County

Location X

Rig up

Drilling and Remarks:

RECORD

Cased \_\_\_\_\_ in., \_\_\_\_\_ ft.

Sand \_\_\_\_\_

Gas \_\_\_\_\_

Oil \_\_\_\_\_

Total Depth \_\_\_\_\_

PRODUCTION

1st 24 hrs. Nat. \_\_\_\_\_

1st 24 hrs. after shot \_\_\_\_\_

Gas \_\_\_\_\_ Cu. Ft.

Dry Hole \_\_\_\_\_

Abandoned \_\_\_\_\_

Date

MAR 8 1950 19

J. E. TYRA Scout

Map No. \_\_\_\_\_ Sec. 30 Twp. 13 R. 13W

Well No. 1 Bell

Shields etal. Company

Contractor

NW SW NW

*E. 1857*

SECTION PLAT



\_\_\_\_\_ Ft. from N. Line

990 Ft. from S. Line

\_\_\_\_\_ Ft. from E. Line

330 Ft. from W. Line

Russell County

RECORD

Location \_\_\_\_\_

Cased \_\_\_\_\_ in., \_\_\_\_\_ ft.

Rig up \_\_\_\_\_

Sand \_\_\_\_\_

Drilling and Remarks:

Gas \_\_\_\_\_

*12" @ 467*

Oil \_\_\_\_\_

*10" @ 865*

Total Depth 3380

*8" @ 2391*

*Jankia 2387*

*Jopeka 2735*

*Kul 2964*

*Douglas 3000*

PRODUCTION

1st 24 hrs. Nat. \_\_\_\_\_

1st 24 hrs. after shot \_\_\_\_\_

Gas \_\_\_\_\_ Cu. Ft.

Dry Hole \_\_\_\_\_

Abandoned \_\_\_\_\_

Date

*Jan 30 1953' Amb 3375 D+A*

APR 19 1950 19

J. E. TYRA Scout