

KANSAS

Russell


FORM 51 5M PETROL

Section 27 Township 13 Range 13W

Well No. #1 Olson

Company M.B.Armer & Lassen

Wildcat

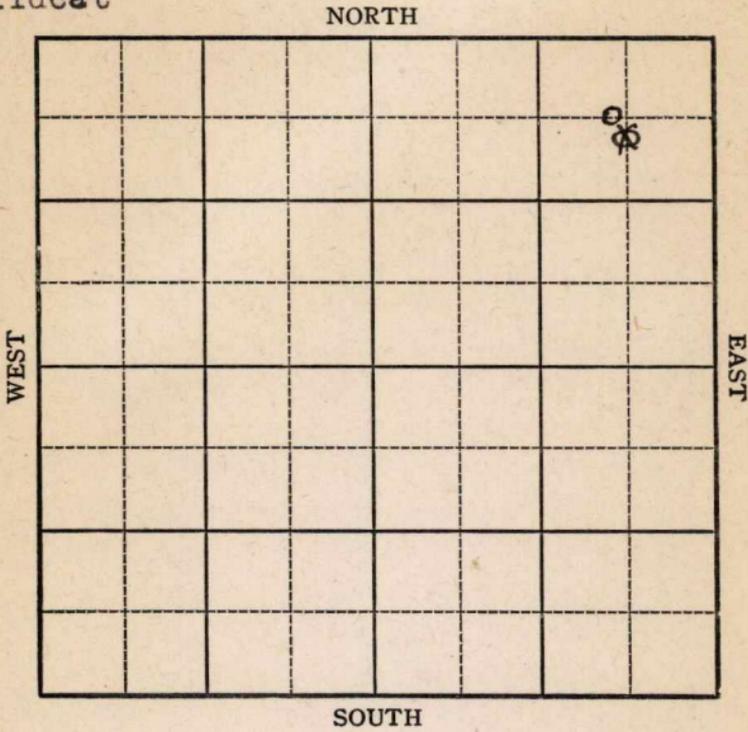

KANSAS

Russell

Sec. 27 Twp. 13 R. 13-W

Well No. #1, Olson Farm

M. B. Armer & Lassen Company


660 Ft. from N. Line

_____ Ft. from S. Line

745 Ft. from E. Line

_____ Ft. from W. Line

Elev. 1819

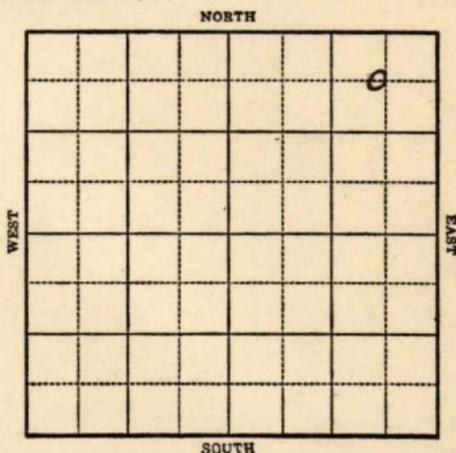

R E P O R T

1943	
12/15	Cable
12/22	<i>Kc#1814</i>
12/29	<i>Drlg. 2002</i>
1944	
1-5	Rigging up
1-12	"
1/19	12" @ 485 <i>Amhy 787</i> 10" @ 795 Drlg. 1020'
1/26	Drlg. 2035'
2/2	8" @ 2460 Drlg. 2500
2/8	8" @ 2504 <i>Topeka 2750</i> Drlg. 2980
2/15	<i>Lans 3060</i> 7" @ 3110 Drlg. 3210

OVER

1944
2/23

Cong 3360
Arb 3407
TD 3422
HFW

ABANDONED

Russell

Map No. 72 ^{KANSAS} Sec. 27 Twp. 13 R. 13W

Well No. 1 Olson

M. B. Armer & Lessen Company

FIRST REPORT Contractor
C NE NE


SECTION PLAT

660 Ft. from N. Line

_____ Ft. from S. Line

745 Ft. from E. Line

_____ Ft. from W. Line

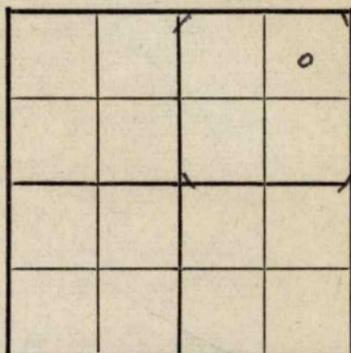

Wildcat

Location _____

Rig up _____

Drilling and Remarks:

Cable

RECORD

Cased _____ in., _____ ft.

Sand _____

Gas _____

Oil _____

Total Depth _____

PRODUCTION

1st 24 hrs. Nat. _____

1st 24 hrs. after shot _____

Gas _____ Cu. Ft.

Dry Hole _____

Abandoned _____

Date

DEC 15 1943 19

S. J. LEWIS Scout

KANSAS

Map No. 7 Sec. 27 Twp. 13 R. 13W

Well No. 1 Olson

M. B. Armer & Lassen Company

ABANDONED

Contractor

C NE NE

SECTION PLAT

660 Ft. from N. Line

_____ Ft. from S. Line

745 Ft. from E. Line

_____ Ft. from W. Line

			o

Wild cat

Location _____

Rig up _____

Drilling and Remarks:

*Comp 3360
Ct 43407
NFW*

RECORD

Cased _____ in., _____ ft.

Sand _____

Gas _____

Oil _____

Total Depth 3422

PRODUCTION

1st 24 hrs. Nat. _____

1st 24 hrs. after shot _____

Gas _____ Cu. Ft.

Dry Hole _____

Abandoned _____

Date

FEB 23 1944 19

S. J. LEWIS Scout