


Section 20 Township 13 Range 17W

Well No. #2 Younger

Company Coppinger & Southern

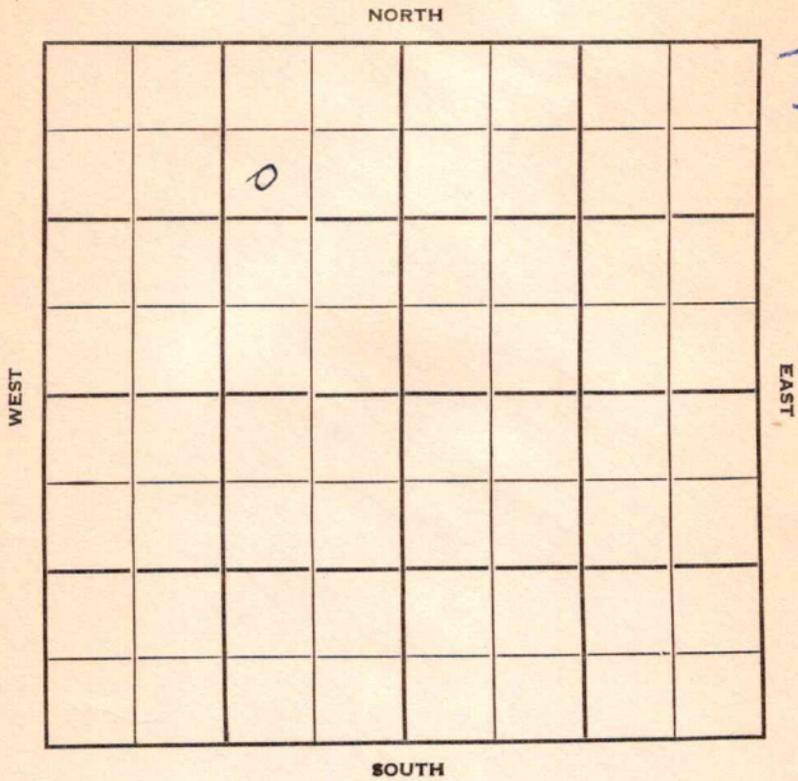

Sec. 20 Twp. 13 R. 17W ✓

Well No. #2 Younger Farm

Coppinger & Southern Company

Contractor


990' Ft. from N. Line

_____ Ft. from S. Line

990' Ft. from E. Line

_____ Ft. from W. Line

SW NE NW

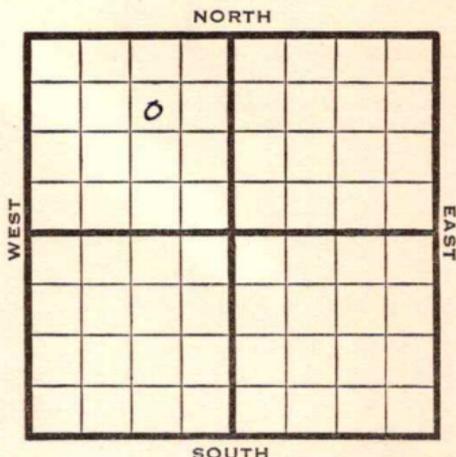

1950

Elev. 2086' REPORT

3/22

8-5/8" @ 240'
Anhy 1295'
Drlg. 3370'

4/19

TD 3459'
8 5/8" @ 240'
Lans 3370'
Show oil 3447-50
and 3456-59
5"@ 3456'
Set Plug 3454'
Perf 24/3347-50
2107 BOPD
Comp

COMPLETED

Kansas

Map No. _____ Sec. 20 Twp. 13 R. 17W

Well No. 2 Younger

Coppinger & Southern Company

Contractor

SW NE NW

E1. 2086
SECTION PLAT

990 Ft. from N. Line

_____ Ft. from S. Line

990 Ft. from E. Line

_____ Ft. from W. Line

| | | | |
|--|---|--|--|
| | 0 | | |
| | | | |
| | | | |
| | | | |

FIRST REPORT

Ellis County

Location _____

Rig up _____

Drilling and Remarks:

8 5/8" @ 240

Anhy 1295

drlg. 3370

RECORD

Cased _____ in., _____ ft.

Sand _____

Gas _____

Oil _____

Total Depth _____

PRODUCTION

1st 24 hrs. Nat. _____

1st 24 hrs. after shot _____

Gas _____ Cu. Ft.

Dry Hole _____

Abandoned _____

Date

MAR 22 1950 19

J. E. Tynn Scout

Kansas

Map No. _____ Sec. 20 Twp. 13 R. 17W

Well No. 2 Younger

Coppinger & Southern Company


Contractor

SW NE NW

EI. 2086

SECTION PLAT

990 Ft. from N. Line

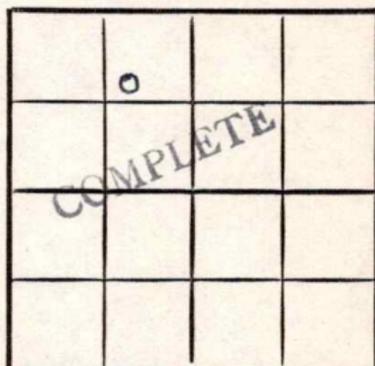

_____ Ft. from S. Line

990 Ft. from E. Line

_____ Ft. from W. Line

Ellis County

Location _____

RECORD

Rig up _____

Cased _____ in., _____ ft.

Sand _____

Drilling and Remarks:

Gas _____

Oil _____

Total Depth 3459

*8 5/8" @ 240
Lans 3370
shaw oil 3447-50
and 3456-59
5" @ 3456
sft plug 3454
perf 24/3347-50*

PRODUCTION

1st 24 hrs. Nat. _____

1st 24 hrs. after shot _____

Gas _____ Cu. Ft.

Dry Hole _____

Abandoned _____

2107 BOPD

Date

APR 19 1950 19

J. E. TYRA Scout