

KANSAS

Russell

Section 32 Township 13 Range 13W

Well No. 1 Schmidt

Company Rine Drlg

Wildcat

NORTH

							0

WEST

EAST

SOUTH

KANSAS

Russell

Sec. 32 Twp. 13 R. 13W

Well No. #1 Schmidt Farm

Rine Drlg.

Company

Wildcat


330' Ft. from N. Line

Ft. from S. Line

330' Ft. from E. Line

Ft. from W. Line

NE/C

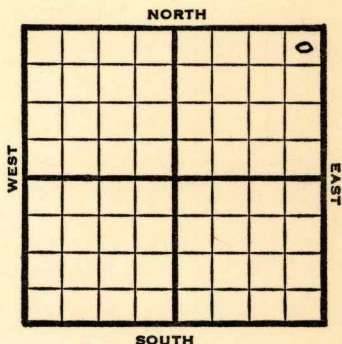

1949

Elev 1844'

REPORT

3/16 RUR

3/23 8" @ 225'
Drlg. 2573'

3/30 Lans 3018'
Arb 3350'
TD 3408'
ABANDONED

Map No. _____ Sec. 32 Twp. 13 R. 13WWell No. 1 Schmidt

Rine Drlg. _____

Company _____

FIRST REPORT

Contractor _____

NE/C


SECTION PLAT

330 Ft. from N. Line

_____ Ft. from S. Line

330 Ft. from E. Line

_____ Ft. from W. Line

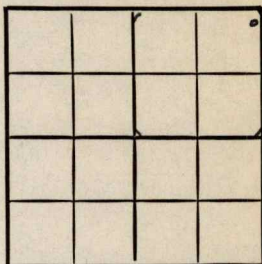

Russell County

Location _____

Rig up _____

Drilling and Remarks:

R U R

RECORD

Cased _____ in., _____ ft.

Sand _____

Gas _____

Oil _____

Total Depth _____

PRODUCTION

1st 24 hrs. Nat. _____

1st 24 hrs. after shot _____

Gas _____ Cu. Ft.

Dry Hole _____

Abandoned _____

Date

MAR 16 1949

19

S. J. LEWIS

Scout

Kansas

Map No. 92 Sec. 32 Twp. 13 R. 13WWell No. 1 Schmidt

Rine Drlg.

Company

ABANDONED

Contractor

NE/C

E 4/1742

SECTION PLAT

330

Ft. from N. Line

Ft. from S. Line

330

Ft. from E. Line

Ft. from W. Line

			0

Russell County

Location

Rig up

Drilling and Remarks:

Lane 3018

Art 5000

RECORD

Cased _____ in., _____ ft.

Sand _____

Gas _____

Oil _____

Total Depth

3405

PRODUCTION

1st 24 hrs. Nat. _____

1st 24 hrs. after shot _____

Gas _____ Cu. Ft.

Dry Hole _____

Abandoned _____

Date

MAR 30 1949

19

S. J. LEWIS

Scout