

Section 21 Township 13 Range 17W

Well No. 1 Hammerschmidt

Company Glenn Nye & L. J. Dreiling

NORTH

0							

4

WEST

EAST

SOUTH

Ellis

KANSAS

Sec. 21 Twp. 13 R. 17 W

Well No. # 1 Hammerschmidt Farm

Glenn Nye & L. J. Dreiling Company

Contractor

Sugar Loaf Pool


990 Ft. from N. Line

Ft. from S. Line

Ft. from E. Line

330 Ft. from W. Line

SW NW NW

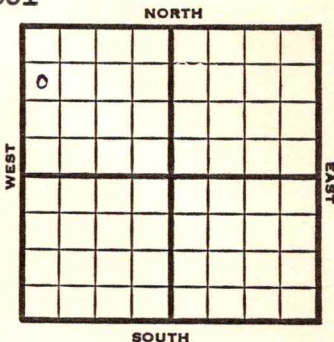

1951

Elev. 2060' REPORT

8/1 Set surface
Drlg. 1450'

8/15 D & A TD 3765'
8" @ 260' **Anky 1295'** **Heeb 3335'**
Lans. 3382' **Cong. 3682'**
TD 3765' D & A

ABANDONED

County Ellis State Kansas

Sec. 21 (Blk.) 13 (Sur.) 17W Map No.

Operator Glenn Nye & L. J. Dreiling

Well No. 1 Farm Hammerschmidt

Elev. 2060 Location SW NW NW

0					

990 Ft. From N Line NW

330 Ft. From W Line Quarter

1st. Report AUG 1 1951

Completion _____

Remarks _____

Spudding Date _____

Drlg. Data Sugar Leaf Pool

set surface drlg. 1450

County Ellis State Kansas

Sec. 21 (Blk. 13 (Sur. 17W (Rge. Map No.)

Operator Glenn Nye & L. J. Dreiling

Well No. 1 Farm Hammerschmidt

Elev. 2060 Location SW NW NW

990 Ft. From N Line NW

330 Ft. From W Line Quarter

Ist. Report

Completion AUG 15 1951

Remarks Sugar Loaf Pool

Spudding Date

Drlg. Data D & A TD 3765

8" @ 260 Anhy 1295 Heeb. 3335

Lans. 3382 Cong. 3682 TD 3765

D & A

J. E. TYRA