
Russell

KANSAS

SECTION 6 TOWNSHIP 13S RANGE 14W

WELL NO. #1 Butcher

COMPANY Keystone Petroleum

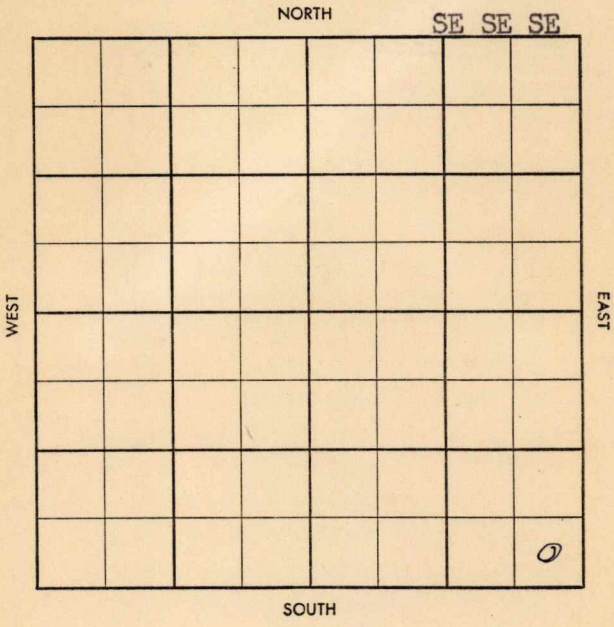

FORM 504-3 SUNRAY

Twp. X Pool X

Co. Y Facet X

S-513-B

County Russell Elev. 1733 DF 1735 KB

Sec. 6 Twp. 13 Rge. 14W

Company Keystone Petroleum

Farm Name Butcher No. 1

TOPS	DEPTH	LOG	DATUM
Anh.	770		
Tp.	2628		
H.	2852		
Tr.	2874		
Dg.			
B.L.			
L.			
K.C.	2907		
B.K.C.			
Ce.			
C.			
M.			
M.			
K.			
Mz.			
Mq.			
V.			
S.			
S.			
A.	3178		
R.			
Pf.			
G.			
T.D.	3193		

Loc. in Sec. SE SE SE

Geol.

Contr. Haynes

Pool Wildcat

ABANDONED

APR 30 '58

Date Comm. 4-17-58

APR 23 '58

NOR 8" 255 @ 2175

APR 30 '58

DST 2804-30 Hr hr 15 MSW BI+P 931/20" DST 2875-90 op 30" 5'M Prm zero/20" 2905-21 op 30" 7'M Prm zero DST 2924-39 op 30" 10'M SCUM BHP 94 DSD 2941-55 op ½ hr 10'M Prm 0/20" DST 3054-72 op 30" 8'M BI+P 1771/20 DST 3173-83 op 30" 6'M Prm 0 D&A

Co. Lse. No. Sec. T. R.

WILDCAT

S–513-B

County Russell Elev.

Sec. 6 Twp. 13 Rge. 14W

Company Keystone Petroleum

Farm Name Butcher No. 1

TOPS	DEPTH	LOG	DATUM
Anh.			
Tp.			
H.			
Tr.			
Dg.			
B. L.			
L.			
K.C.			
B.K.C.			
Ce.			
C.			
M.			
M.			
K.			
Mz.			
Mq.			
V.			
S.			
S.			
A.			
R.			
Pf.			
G.			
T.D.			

Loc. in Sec. SE SE SE

X

Geol.

Contr. Haynes

Pool Wildcat

APR 16 58

FIRST REPORT

O

Date Comm. NOR

Co. Lse. No. Sec. T. R.