

Russell

KANSAS

SECTION 7 TOWNSHIP 13 RANGE 14 W

WELL NO. #1 Rogg

COMPANY B. W. Shindhelm et al

NORTH

WEST								EAST

SOUTH

0

Russell

KANSAS

SEC.

TWP.

R.

7

13

14W

WELL NO.

#1 Rogg

FARM

COMPANY

B.W. Shindhelm etal

CONTRACTOR

Mast

N. Atherton


Ft. from N. Line

Ft. from S. Line

Ft. from E. Line

Ft. from W. Line

NW SE SW

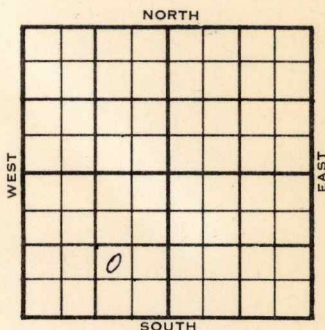

1956

ELEVATION

1798 KB, 1795 DF REPORT

1-11

Comm. 1-7-56

8" @ 200

Brlg. 1600'

1-18

DST 2964-77 op 45 min. rec. 4' mud,
35/20"DST 3005-18 op 45 min. rec. 14' sgcw
100/20"DST 3242-54 op 1 hr. rec. 170' muddy
sul. wtr. 1005/20"

D & A

Anh. 860

Tp. 2688

H. 2915

Tr. 2936

L. 2968

A. 3240

TD 3254'

ABANDONED

County Russell Elev. _____
 Sec. 7 Twp. 13 Rge. 14W
 Company B. W. Shindhelm et al.
 Farm Name Rogg No. 1

TOPS	DEPTH	LOG	DATUM	Loc. in Sec.
Anh.				NW SE SW
T.P.				
H.				
Tr.				
Dg.				
B.L.				
L.				Geol.
K.C.				Contr.
B.K.C.				Mast
Ce.				Pool
C.				N. Atherton
M.				
M.				
K.				
Mz.				
Ma.				
V.				
S.				
S.				
A.				
R.				
Pe.				
G.				
T.D.				

FIRST REPORT

JAN 1 1956

Date Comm. 1-7-56
8" @ 200 drlg. 1600

