


Russell

KANSAS

Section 2 Township 13 Range 14W

Well No. #1 Dumler

Company Nadel & Gussman

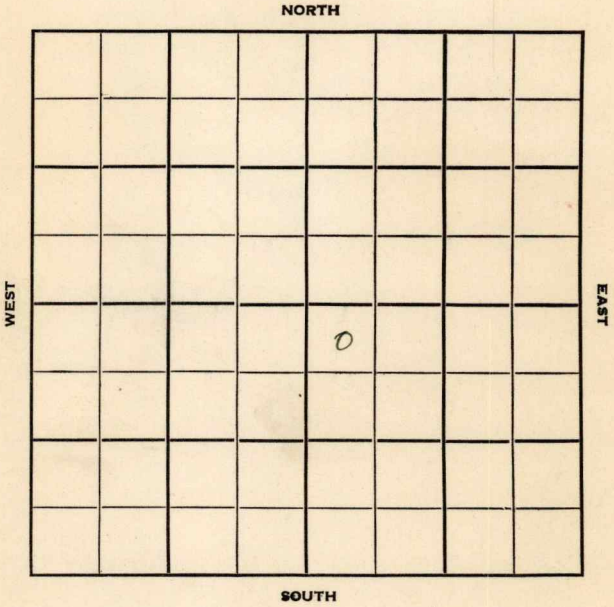

Russell KANSAS



Sec. 2 Twp. 13 R. 14 W

Well No. # 1 Dumlér Farm

Nadel & Gussman Company

Reserve Drlg. Contractor

Wildcat


330 Ft. from N. Line

Ft. from S. Line

Ft. from E. Line

330 Ft. from W. Line

NW NW SE

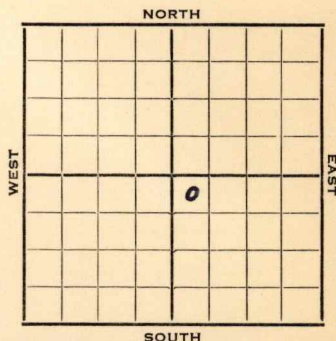

1952

Eleb. 1644'

REPORT

9/24

Drilling

10/1

D & A TD 3200' 8" @ 231

Heeb 2778' Lans. 2834' Arb. 3157'

TD 3200' D & A

ABANDONED

County Russell State KansasSec. 2 (Blk. Twp.) 13 (Sur. Rge.) 14W Map No.Operator Nadel & GussmanWell No. 1 Farm DumlerElev. 1644 Location NW NW SE

330 Ft. From N Line SE330 Ft. From W Line Quarter1st. Report SEP 24 1952

Completion _____

Remarks _____

Reserve Drlg. - Contr.

Spudding Date _____

Drlg. Data Wildcatdrlg.

County Russell State Kansas
 Sec. 2 (Blk. 13 (Sur. 14W Map No.
 Operator Nadel & Gussman
 Well No. 1 Farm Dumler
 Elev. 1644 Location NW NW SE



330 Ft. From N Line SE
330 Ft. From W Line Quarter
1st. Report
Completion OCT 1 1952
Remarks Wildcat
Reserve Drlg. - Contr.
Spudding Date

Drlg. Data D & A TD 3200
8" @ 231 Heeb. 2778 Lans. 2834
Arb. 3157 TD 3200

D & A

J. G. McGEHEE