


KANSAS

Russell

Section 5 Township 13 Range 14WWell No. 1 FosterCompany Peel & HartmanWildcat
NORTH

WEST

EAST

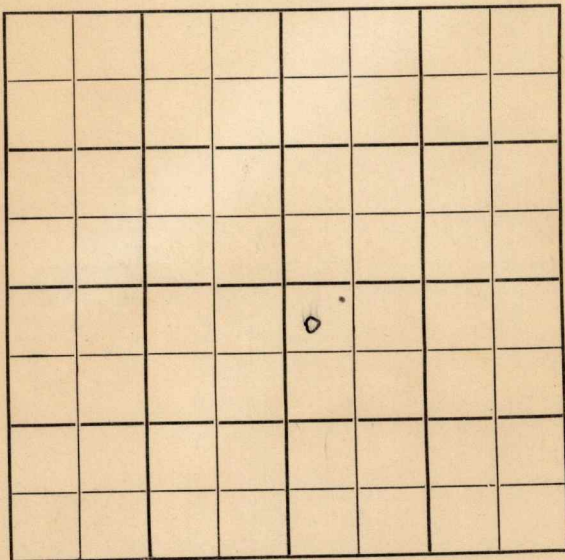

SOUTH

KANSAS

Russell

Sec. 5 Twp. 13 R. 14W ✓

Well No. #1 Foster Farm

Peel & Hartman Company


Wildcat

330' Ft. from N. Line

_____ Ft. from S. Line

_____ Ft. from E. Line

330' Ft. from W. Line

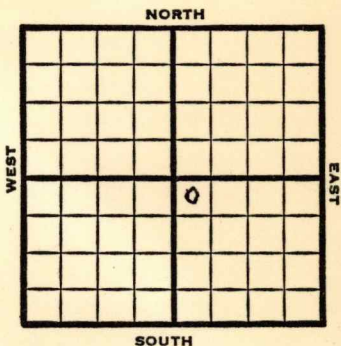

NW SE

1949

Elev 1668'

REPORT

4/20

Drlg. 410'

4/27

8" @ 719'

rlg 2985'

5/4

TD 3159'

Arb. 3145'

Aband.

ABANDONED

Map No. _____ Sec. 5 Twp. 13 R. 14W

Well No. 1 Foster

Peel & Hartman Company

FIRST REPORT Contractor

NW SE


SECTION PLAT

330 Ft. from N. Line

_____ Ft. from S. Line

_____ Ft. from E. Line

330 Ft. from W. Line

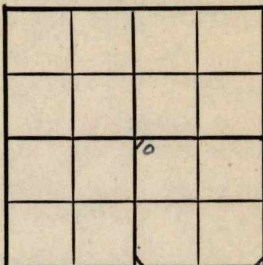

Russell County

Location _____

Rig up _____

Drilling and Remarks:

drlg. 410

RECORD

Cased _____ in., _____ ft.

Sand _____

Gas _____

Oil _____

Total Depth _____

PRODUCTION

1st 24 hrs. Nat. _____

1st 24 hrs. after shot _____

Gas _____ Cu. Ft.

Dry Hole _____

Abandoned _____

Date

APR 20 1949 19

S. J. LEWIS Scout

Map No. K-72 Sec. 5 Twp. 13 R. 14W

Well No. 1 Foster

Peel & Hartman Company

ABANDONED

Contractor

NW SE

E11665
SECTION PLAT

330 Ft. from N. Line

Ft. from S. Line

Ft. from E. Line

330 Ft. from W. Line

		8	

Russell County

Location

Rig up

Drilling and Remarks:

Cor 3/40

RECORD

Cased _____ in., _____ ft.

Sand _____

Gas _____

Oil _____

Total Depth 8155

PRODUCTION

1st 24 hrs. Nat. _____

1st 24 hrs. after shot _____

Gas _____ Cu. Ft.

Dry Hole _____

Abandoned _____

Date

MAY 4 1949

19

S. J. LEWIS Scout