
DX 78-1

Russell KANSAS

Section 5 Township 13 Range 14 W

Well No. # 1 Foster

Company Veeder Supply & Development

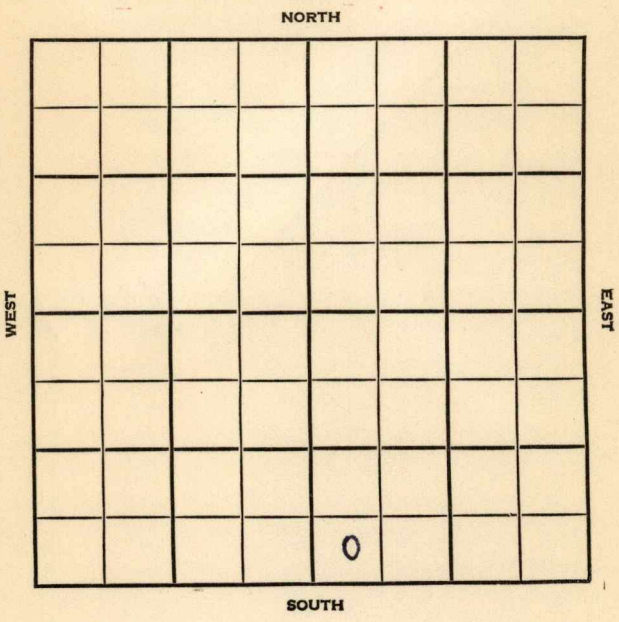

Russell KANSAS

SEC.	TWP.	R.
5	13	14W

WELL NO. 1

FARM Foster

COMPANY Veeder Supply & Development

CONTRACTOR Co. Tools


Wildcat

_____ Ft. from N. Line

330 Ft. from S. Line

_____ Ft. from E. Line

330 Ft. from W. Line

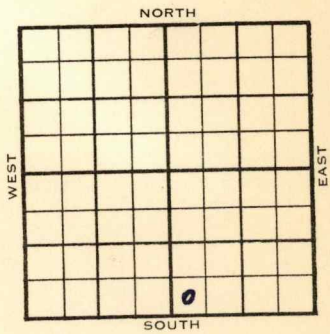

SW SW SE

Shields & El Dorado DHM

ELEVATION 1802'

1955 REPORT

3/16 Cellar & Pits

3/30 Spud 3-16-55
D & A
TD 3266'
8" @ 217'
Top 2701'
DST 2877'-2900' opn ½ hr, rec 15' Mud
900#
Heeb. 2926', Tor. 2948' Lans 2979'
DST 2982'-3025' opn ½ hr, rec 240' msw
900#
DST 3140'-3200' opn 1½ hr, rec 40' mw
0# Arb. 3262'
DST 3260'-66' opn 1 hr, rec 40' wtr.
860#
TD 3266'
D& A

ABANDONED

DX-78

FORM 275 FOR SALE BY KANSAS BLUE PRINT CO.


County Russell State Kansas

Sec. 5- (Blk. Twp.) 13 (Sur. Rge.) 14W Map No.

Operator Veeder Supply & Development

Well No. 1 Farm Foster

Elev. Location SW SW SE

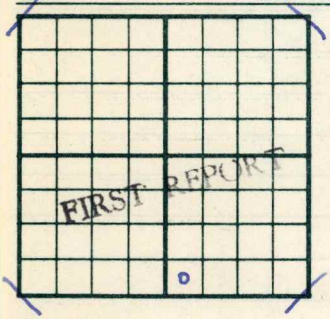

330 Ft. From S Line SE

330 Ft. From W Line Quarter

1st. Report MAR 1 6 1955

Completion

Remarks Shields & ElDorado Co. tools DHM

Spudding Date

Drlg. Data Wildcat

Cellar & pits

FABEN GILSTRAP

FORM 275 FOR SALE BY KANSAS BLUE PRINT CO.

County Russell State Kansas

Sec. 5 (Blk. Twp.) 13 (Sur. Rge.) 14W Map No.

Operator Veeder Supply & Development

Well No. 1 Farm Foster

Elev. 1802 Location SW SW SE



330 Ft. From S Line SE

330 Ft. From W Line Quarter

1st. Report

Completion MAR 3 0 1955

Remarks Wildcat

Co. tools

Spudding Date 3-16-55

Drlg. Data D & A TD 3266

8" @ 217 Top. 2701 DST 2877-2900

open ½ hr. Rec. 15' mud 900#

Heeb. 2926 Tor. 2948 Lans. 2979

DST 2982-3025 open ½ hr. Rec. 240' msw

900# DST 3140-3200 open 1½hr.

Rec. 40' mw 0# Arb. 3262 DST 3260-66

open 1 hr. Rec. 40' wtr. 860#

TD 3266

D & A

FABEN GILSTRAP