


Section 17 Township 33 Range 3 E

Well No. # 1 Watts

Company Wakefield

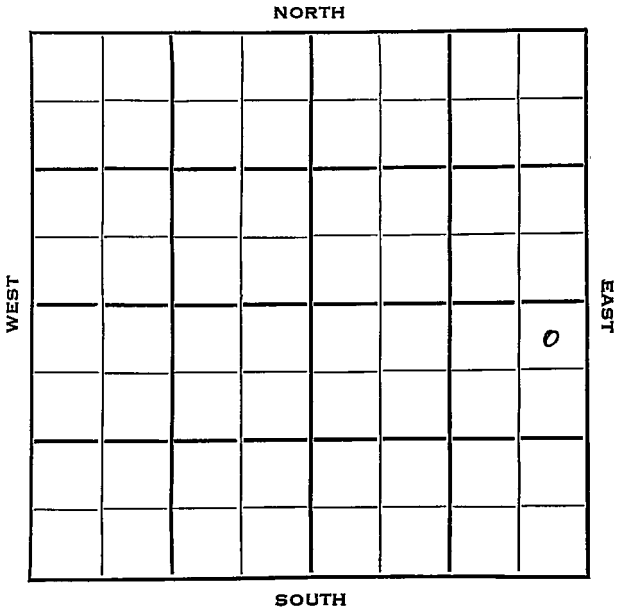

SEC. 17	TWP. 33	R. 3E ✓
------------	------------	------------

WELL NO. 1 Watts FARM

COMPANY Wakefield

CONTRACTOR Wakefiled


Rainbow Bend Pool

330 Ft. from N. Line

Ft. from S. Line

330 Ft. from E. Line

Ft. from W. Line

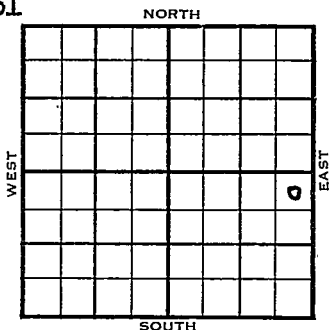

NE NE SE

1954	ELEVATION	REPORT
------	-----------	--------

3/10

Layton 2561', Bart 3176'
TD 3201'
D&A

FIRST REPORT



ABANDONED

County Cowley State Kansas

Sec. 17 (Blk. 33 (Sur. Rge.) 3E Map No.

Operator Wakefield

Well No. 1 Farm Watta

Elev. Location NE NE SE

FIRST REPORT							
ABANDONED							
							0

330 Ft. From N Line SE

330 Ft. From E Line Quarter

1st. Report MAR 10 1954

Completion MAR 10 1954

Remarks

Wakefield - Contr.

Spudding Date

Drlg. Data Rainbow Bend Pool

Layton 2561 Bart. 3176 TD 3201

D & A