

KANSAS


Russell County

FORM 51 5M PETROL

Section 7 Township 13 Range 14W

Well No. 1 Rogg "A"

Company Derby etal

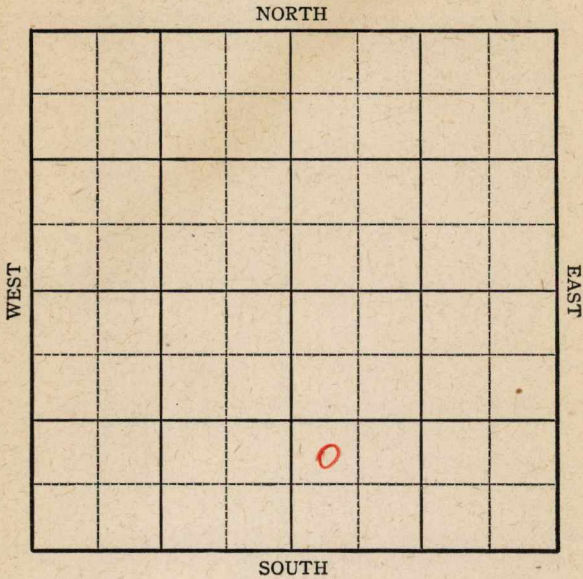

KANSAS

Russell

Sec. 7 Twp. 13 R. 14W

Well No. 1 Rogg "A" Farm

Derby etal Company


Wildcat

Ft. from N. Line

990 Ft. from S. Line

Ft. from E. Line

330 Ft. from W. Line

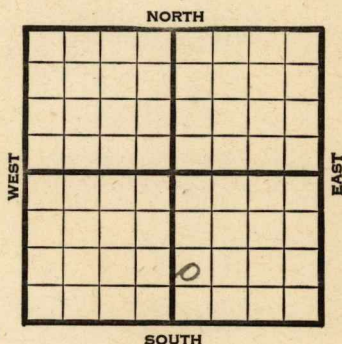

NW SW SE Elev. 1792

1945

REPORT

Date	Location
6/27	Location
7/3	8" @ 410' WOC
7/11	Drlg. 2882'
7/19	Lans. 3006
	Arb. 3232-3235
	TD 3235' Sat.
	5" @ 3232' RUST
7/26	24 shots on bottom
	500 acid. Swab 1 oil plus 5 Wtr. per h
8/1	Arb. 3232
	5" @ 3232
	T.D. 3265'

ABANDONED

Kansas Pool Name WildcatMap No. 72 Sec. 7 Twp. 13 R. 14WWell No. 1 Rogg "A"Derby etal


Company

FIRST REPORT

Contractor

NW SW SE

SECTION PLAT

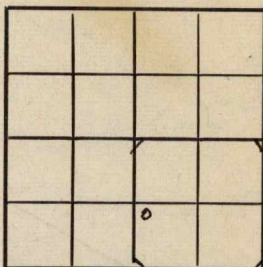 Ft. from N. Line990 Ft. from S. Line Ft. from E. Line330 Ft. from W. LineRussell CountyLocation XRig up

Drilling and Remarks:

RECORD

Cased in., ft.Sand Gas Oil Total Depth

PRODUCTION

1st 24 hrs. Nat. 1st 24 hrs. after shot Gas Cu. Ft.Dry Hole Abandoned

Date

JUN 27 1945 19S. J. LEWIS

Scout

KANSAS

KANSAS

Pool Name WildcatMap No. 72 Sec. 7 Twp. 13 R. 14WWell No. 1 Rogg "A"Derby etal

Company

ABANDONED

Contractor

NW SW SE

E1/792

SECTION PLAT

		0	

Ft. from N. Line990 Ft. from S. LineFt. from E. Line330 Ft. from W. LineRussell County

Location _____

Rig up _____

Drilling and Remarks:

Ar 832325 "83235"**RECORD**

Cased _____ in., _____ ft.

Sand _____

Gas _____

Oil _____

Total Depth 3265**PRODUCTION**

1st 24 hrs. Nat. _____

1st 24 hrs. after shot _____

Gas _____ Cu. Ft.

Dry Hole _____

Abandoned _____

Date

AUG 1 1945 19S. J. LEWIS Scout