


Section 9 Township 13 Range 14W

Well No. #1 Solbach

Company Lindas Oil

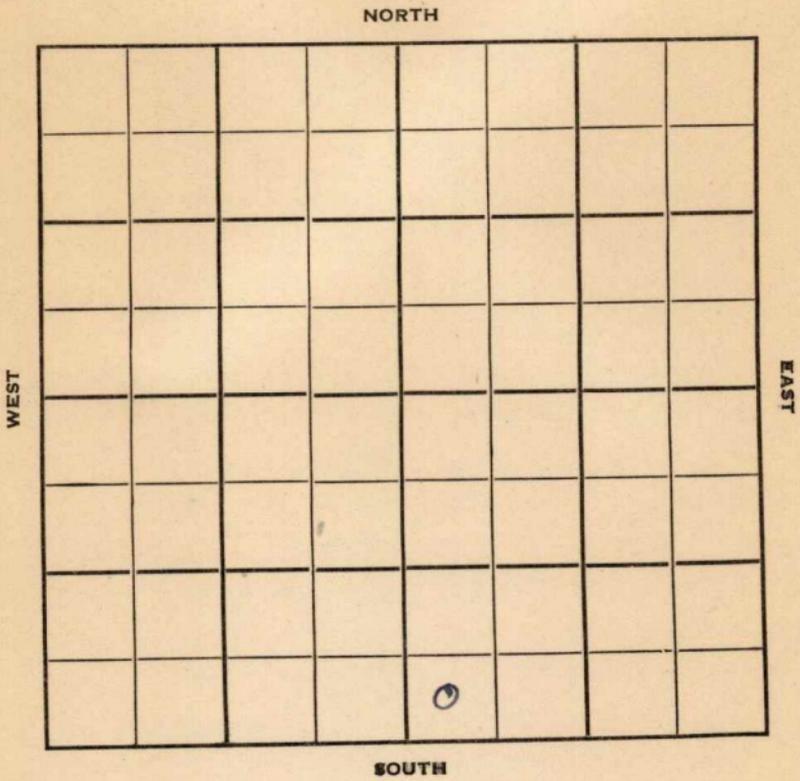

Russell

KANSAS



Sec. 9 Twp. 13 R. 14W

Well No. #1 Solbach Farm

Lindas Oil Company

Contractor


Ft. from N. Line

330 Ft. from S. Line

Ft. from E. Line

330 Ft. from W. Line

SE  $\frac{1}{4}$  SW SW SE

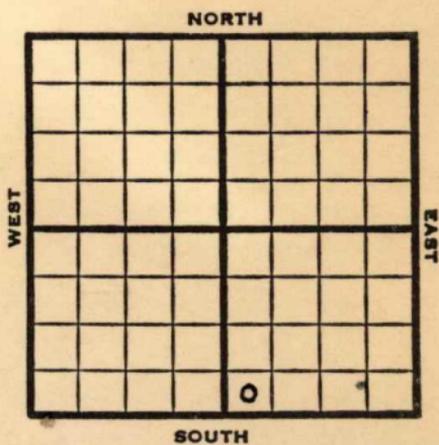

1952

**Elev. 1816'** REPORT

11/5 MIR

11/12 8" @ 160'

**Anhy 865'**

Drlg. 1550'

11/20 Drlg. 3064'

11/26 Spud 11-8-52

D & A T<sup>U</sup> 3340' 8" @ 160

**Anhy 865' Heeb 2955' Lans. 3015'**

**B KC 3280'**

DST 3173-3208 open 1 hr. rec 60' mud

& SW **Cong. 3298' Arb. 3323'**

TD 3340' D & A

**ABANDONED**



