

KANSAS


Russell

FORM 51 25M 3-49 PETROL

Section 15 Township 13 Range 14-W

Well No. #1 Furthmeyer

Company B & R Drlg et al

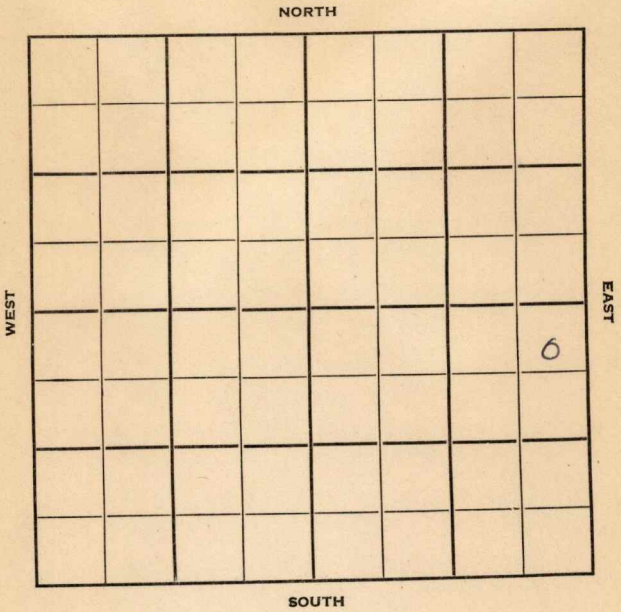

Russell **KANSAS**

Sec. 15 Twp. 13 R. 14W

Well No. #1 Furthmeyer Farm
B & R Drlg., et al Company

Wildcat


330' Ft. from N. Line

 Ft. from S. Line

330' Ft. from E. Line

 Ft. from W. Line

NE NE SE

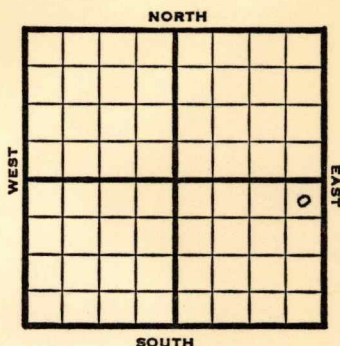

1950 **Elev. 1804'** REPORT

1/11 MIT

1/25 8" @ 130'

Anh 830'

Lans 2978'

Cong 3268'

Arb 3310'

TD 3318'

D&A

ABANDONED

Wildcat

Map No. _____ Sec. 15 Twp. 13 R. 14^WWell No. 1 FurthmeyerB & R Drlg. etal.

Company _____

Contractor _____

NE NE SE

SECTION PLAT

330 Ft. from N. Line

_____ Ft. from S. Line

330 Ft. from E. Line

_____ Ft. from W. Line

FIRST REPORT			
			0

Russell County

Location _____

Rig up _____

Drilling and Remarks:

M I T

RECORD

Cased _____ in., _____ ft.

Sand _____

Gas _____

Oil _____

Total Depth _____

PRODUCTION

1st 24 hrs. Nat. _____

1st 24 hrs. after shot _____

Gas _____ Cu. Ft.

Dry Hole _____

Abandoned _____

Date

JAN 11 1950J. E. TYRA

Scout

Kansas

Wildcat

Map No. _____ Sec. 15 Twp. 13 R. 14WWell No. 1 Furthmeyer

B & R Drlg. etal.

Company

Contractor

NE NE SE

E. 1804
SECTION PLAT330 Ft. from N. Line

_____ Ft. from S. Line

330 Ft. from E. Line

_____ Ft. from W. Line

Russell County

ABANDONED			
			o

Location _____

Rig up _____

Drilling and Remarks:

8" @ 130Anh 830Lans 2978cong 3268arb 3310D & A

RECORD

Cased _____ in., _____ ft.

Sand _____

Gas _____

Oil _____

Total Depth 3318

PRODUCTION

1st 24 hrs. Nat. _____

1st 24 hrs. after shot _____

Gas _____ Cu. Ft.

Dry Hole _____

Abandoned _____

Date

JAN 25 195019J. E. TYRAScout