

Russell

Map No. **KANSAS** Sec. 16 Twp. 13 R. 14^W


Well No. 1- Bender Farm
Palmer Oil Company

_____ Ft. from N. Line

330 Ft. from S. Line

_____ Ft. from E. Line

990 Ft. from W. Line

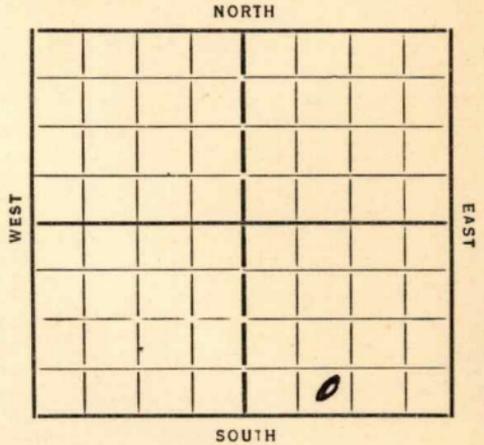

REPORT

Date		
1935		
5/1	Mag.	
5/9	Rig	
5/16		
5/23	dly 375	15" 353
5/29	" 625	12" 570
6/6	" 1720	12" 865
6/13	" 2570	10" 2460
6/20	" 3275	8" 3025
	Oswald 3025	W. 3125
6/26	Sil 3343	T 7 3343 HFW

ABANDONED

Form 26-1M Bks. 928

Russell
Map No. 72 Sec. 16 Twp. 13 R. 14W

Well No. 1-Bender

Palmer Oil Company

Contractor

FIRST REPORTS

SECTION PLAT

..... Ft. from N. Line

330 Ft. from S. Line

..... Ft. from E. Line

990 Ft. from W. Line

			0

Location.....

Rig up.....

Drilling and Remarks:

Moq

RECORD

Cased..... in., ft.

Sand.....

Gas.....

Oil.....

Total Depth.....

PRODUCTION

1st 24 hrs. Nat.....

1st 24 hrs. after shot.....

Gas..... Cu. Ft.

Dry Hole.....

Abandoned.....

Date

5-1-35 192.....

ORVAL MANNSCHECK

Scout

KANSAS

Map No. 72 Sec. 16 Twp. 13 R. 14N

Well No. 1 Bender

Palmer Oil Company

Contractor

SECTION PLAT

..... Ft. from N. Line

330 Ft. from S. Line

..... Ft. from E. Line

990 Ft. from W. Line

ABANDONED

Location.....

Rig up.....

Drilling and Remarks:

Oil 3343
HFW

RECORD

Cased..... in., ft.

Sand.....

Gas.....

Oil.....

Total Depth 3343

PRODUCTION

1st 24 hrs. Nat.....

1st 24 hrs. after shot.....

Gas..... Cu. Ft.

Dry Hole.....

Abandoned.....

Date

7/26/35 192.....

ORVAL MANNSCHRECK

Scout