


Section 15 Township 13 Range 14W

Well No. #1 Furthmeyer "C"

Company Murfin Drlg.

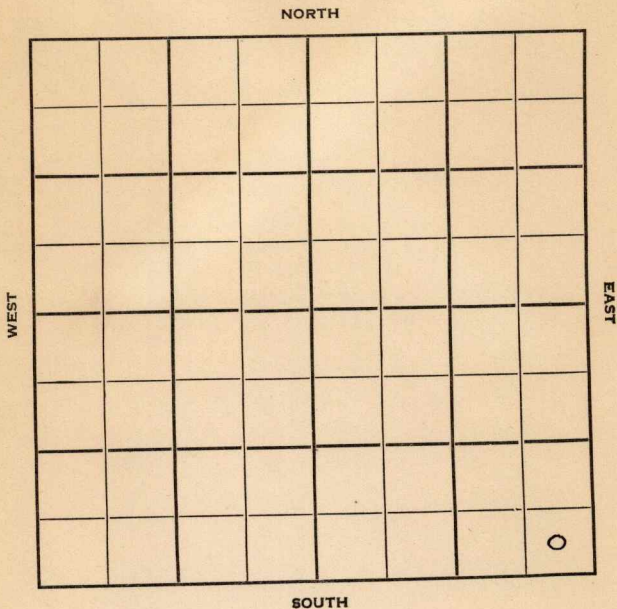

Russell

KANSAS

Sec. 15 Twp. 13 R. 14W ✓

Well No. #1 Furthmeyer "C" Farm

Murfin Drlg. Company

Murfin Drlg. Contractor
Russell Pool


_____ Ft. from N. Line

330' Ft. from S. Line

330' Ft. from E. Line

_____ Ft. from W. Line

SE SE SE

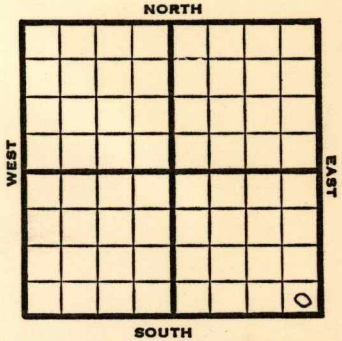

1951 **Elev. 1840'** REPORT

8/22 Spud 8-22-51
Drlg.

9/12 Spud 8-22-51 D & A TD 3360'
 8-5/8" @ 175 **Anhy 868-902'**
Heeb 2959' **Lans. 3018'**
 DST 3020-42 open $\frac{1}{2}$ hr. rec 25' mud &
 SSO **Cong. 3302'** **Arb. 3349-60'** TD
 D & A

ABANDONED

