


Map No. K Sec. 19 Twp. 33 R. 3^E

Well No. 1 Heskitt Farm

J.B. Slick & W. Phillips Company

NORTH

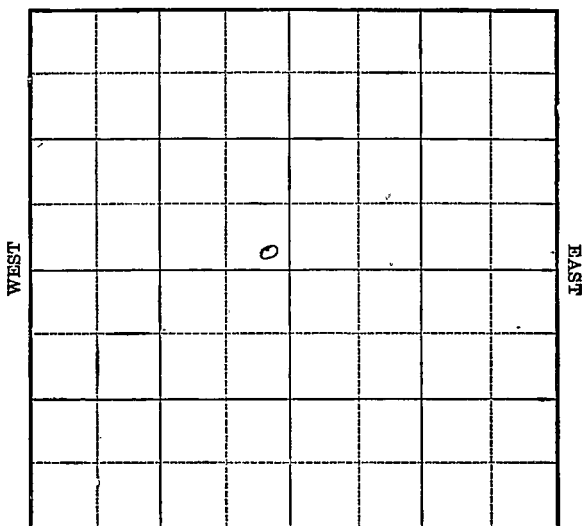

SOUTH

Location _____

Drilling Remarks:

RECORD

Cased _____ in. _____ ft.
 Sand _____
 Gas _____
 Oil _____
 Total Depth _____

Rig Up _____

Drilling Remarks:

PRODUCTION

1st 24 hrs. Nat. _____
 1st 24 hrs. after shot _____
 Gas _____ cu. ft.
 Dry Hole _____
 Abandoned _____

Map No. **KANSAS** Sec. 19 Twp. 33 R. 3E

Well No. 1 Heshet
T. B. Sliak & White Phillips
 Company

Contractor

FIRST REPORT

SECTION PLAT

----- Ft. from N. Line

330 Ft. from S. Line

330 Ft. from E. Line

----- Ft. from W. Line

	0		

Location ✓✓

Rig up -----

Drilling and Remarks:

RECORD

Cased ----- in., ----- ft.

Sand -----

Gas -----

Oil -----

Total Depth -----

PRODUCTION

1st 24 hrs. Nat. -----

1st 24 hrs. after shot -----

Gas ----- Cu. Ft.

Dry Hole -----

Abandoned -----

Date NOV 6 1924

M. A. BENEAR

Cowley Co

Map No. KANSAS Sec. 19 Twp. 33 R. 3E

Well No. 1 - Kerkel

J. B. Lick & Walter Phillips
Company

Contractor

COMPLETED SECTION PLAT

----- Ft. from N. Line

330 Ft. from S. Line

330 Ft. from E. Line

----- Ft. from W. Line

	0		

Location -----

Rig up ----- 5

Drilling and Remarks:

Sand shale 3180-84'
@ 3184-89
Broken s. 3189-3202
sand 3202-07
Chat 3207 1/2 TD,
30/75 lbs.

RECORD

Cased ----- in., ----- ft.
Sand -----
Gas -----
Oil -----
Total Depth -----

PRODUCTION

1st 24 hrs. Nat. -----
1st 24 hrs. after shot -----
Gas ----- Cu. Ft.
Dry Hole -----
Abandoned -----

Date

APR 23 1925

M. A. BENEAR