


Section 18 Township 13 Range 14-W

Well No. 1 Dutt

Company Cities Service Oil

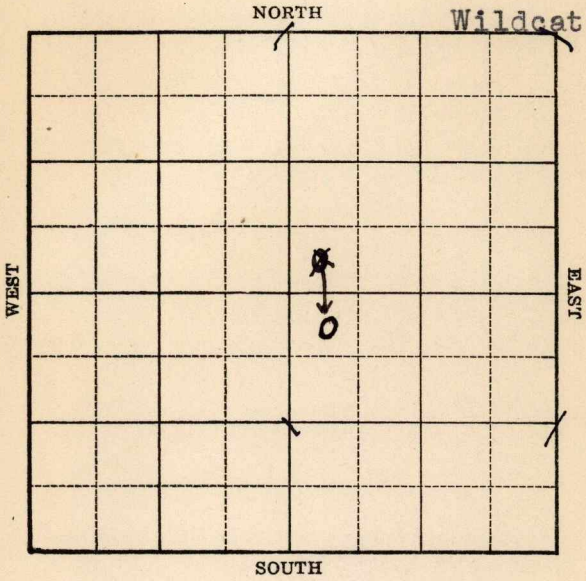



1939  
6/28

Arb. 3120'

7" - 3122'

T.D. 3134'

1000 acid.

Potential 241 bbls., pump.

**COMPLETED**

Russell

Map No. 72 Sec. 18 Twp. 13 R. 14W

Well No. 1 Dutt

Cities Service Oil Company

Contractor

FIRST REPORT  
SW NE

           Ft. from N. Line


330 Ft. from S. Line

           Ft. from E. Line

330 Ft. from W. Line

WILDCAT

SECTION PLAT

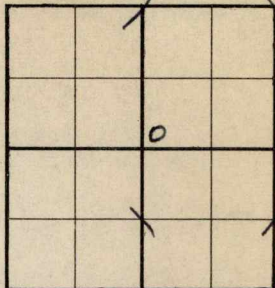

Location X

Rig up           

Drilling and Remarks:

RECORD

Cased            in.,            ft.

Sand           

Gas           

Oil           

Total Depth           

PRODUCTION

1st 24 hrs. Nat.           

1st 24 hrs. after shot           

Gas            Cu. Ft.

Dry Hole           

Abandoned           

Date

APR 5 - 1939

19

H. D. Hatfield Scout

Russell **KANSAS**

Map No. 72 Sec. 18 Twp. 13 R. 14<sup>W</sup>

Well No. 1-Dutt

Cities Service Company

Contractor

*nw se*  
**CORRECTION**

**SECTION PLAT**

		02	

440 Ft. from N. Line

\_\_\_\_\_ Ft. from S. Line

\_\_\_\_\_ Ft. from E. Line

440 Ft. from W. Line

**CORRECTION**

Location \_\_\_\_\_

Rig up \_\_\_\_\_

Drilling and Remarks:

*first reported  
gas sw ne  
Corrected to  
nw se*

**RECORD**

Cased \_\_\_\_\_ in., \_\_\_\_\_ ft.

Sand \_\_\_\_\_

Gas \_\_\_\_\_

Oil \_\_\_\_\_

Total Depth \_\_\_\_\_

**PRODUCTION**

1st 24 hrs. Nat. \_\_\_\_\_

1st 24 hrs. after shot \_\_\_\_\_

Gas \_\_\_\_\_ Cu. Ft.

Dry Hole \_\_\_\_\_

Abandoned \_\_\_\_\_

Date

APR 19 1939 19

E. D. Hatfield

Scout

Russell **KANSAS**

Map No. 72 Sec. 18 Twp. 13 R. 14W

Well No. 1 Dutt

Cities Service Oil Company

Contractor

**COMPLETED**

**SECTION PLAT**

NW SE

440 Ft. from N. Line

\_\_\_\_\_ Ft. from S. Line

\_\_\_\_\_ Ft. from E. Line

440 Ft. from W. Line

		0	

**WILDCAT**

Location \_\_\_\_\_

Rig up \_\_\_\_\_

Drilling and Remarks:

*Cr 8 3120*  
*7" @ 3122*  
*1000 and*  
*Pump 241 P.S.*

**RECORD**

Cased \_\_\_\_\_ in., \_\_\_\_\_ ft.

Sand \_\_\_\_\_

Gas \_\_\_\_\_

Oil \_\_\_\_\_

Total Depth 3134

**PRODUCTION**

1st 24 hrs. Nat. \_\_\_\_\_

1st 24 hrs. after shot \_\_\_\_\_

Gas \_\_\_\_\_ Cu. Ft.

Dry Hole \_\_\_\_\_

Abandoned \_\_\_\_\_

Date

JUN 28 1939

19

S. J. LEWIS Scout