

Section 18 Township 13 Range 14WWell No. #1 OlsenCompany Mohawk Drlg.

NORTH

							0

SOUTH

WEST EAST

Russell

KANSAS

Sec. 18 Twp. 13 R. 14 W

Well No. # 1 Olsen Farm

Mohawk Drlg. Company

Stearn Drlg. Contractor

Atherton Pool


 Ft. from N. Line

990 Ft. from S. Line

330 Ft. from E. Line

 Ft. from W. Line

NE SE SE

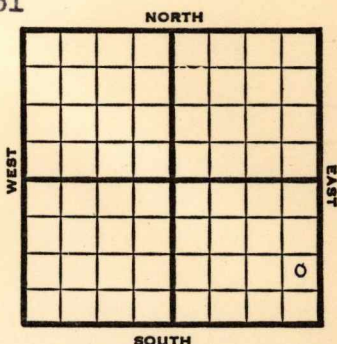

1951 Elev. 1808' REPORT

8/8 Spud 7-31-51
8" @ 220'
Anhy 875-905'
Drlg. 1400'

9/29 Spud 7-31-51
D&A TD 3263
8" @ 220'
Anhy 875-905 Heeb. 2931 KC 2975
DST 2987-3015 open 1/2 hr.
Rec. 10' mud
DST 3020-35 open 1 hr. TD 3263'
5" @ 3257
Arb. 3255 DC 3263
B/ 30 goph 350 A B/ 25 go
43 gw SP 3257' 24/3247-55
500 A Fu 250' fluid PB 3110'
12/ 3059-62 22/ 3052-53
48 /3024-32 500 A B/ 8 gw
1 1/2 go 5 hr.
D&A

ABANDONED

County Russell State Kansas
 Sec. 18 (Blk.) 13 (Sur.) 14W Map No.
 Operator Mohawk Drlg.
 Well No. 1 Farm Olsen
 Elev. _____ Location NE SE SE

FIRST REPORT									

990 Ft. From S Line SE
330 Ft. From E Line Quarter
 1st. Report AUG 8 1951

Completion _____

Remarks _____

Stearn Drlg. - Contr.

Spudding Date 7-31-51


Drlg. Data _____

Atherton Pool

8" @ 220 Anhy 875-905 drlg. 1400

J. E. TYRA

County Russell State Kansas
 Sec. 18 (Blk. 13) (Sur. 14W) Map No. 13
 Operator Mohawk Drlg.
 Well No. 1 Farm Olsen
 Elev. 1808 Location NE SE SE

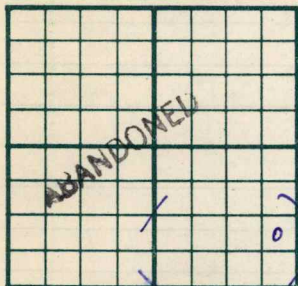

990 Ft. From S Line SE
330 Ft. From E Line Quarter
 1st. Report _____
 Completion SEP 26 1951
 Remarks Atherton Pool
Stearn Drlg. - Contr.
 Spudding Date 7-31-51

Drlg. Data D & A TD 3263
8" @ 220 Anhy 875-905 Heeb. 2931
KC 2975 DST 2987-3015 open $\frac{1}{2}$ hr.
Rec. 10' mud DST 3020-35 open 1 hr.
TD 3263 5" @ 3257 Arb. 3255 DC 3263
B/ 30 goph 350 A B/ 25 go 43 gw
SP 3257 24/ 3247-55 500 A FU 250'
fluid PB 3110 12/ 3059-62 22/ 3052-53
48/ 3024-32 500 A B/ 8 gw $1\frac{1}{2}$ go 5 hr.

D & A

J. E. TYRA